


HAROLD H. KOLB

REGISTERED PROFESSIONAL LAND SURVEYOR
LAKE GENEVA, WISCONSIN

PHOENIX STREET

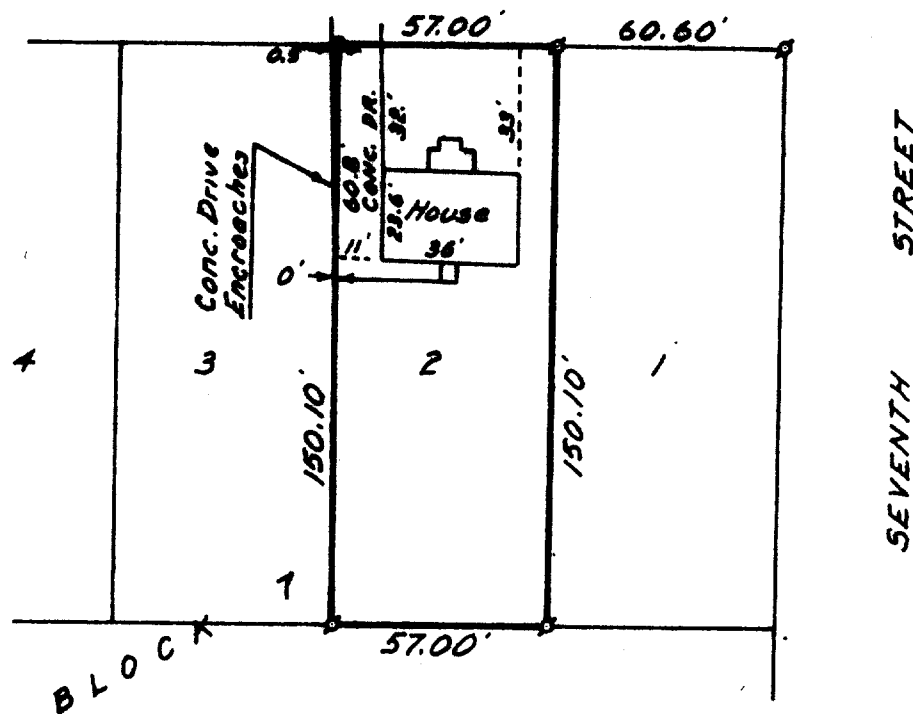

PLAT OF SURVEY OF

Lot 2, Block 7, in Fairview Heights, in
the City of Delavan, County of Walworth,
and State of Wisconsin, as per plat re-
corded in the Office of the Register of
Deeds in said County.

N

Scale 1"=50'

LEGEND

- ⊗ - IRON PIPE FOUND
- - IRON PIPE PLACED
- - CONCRETE MONUMENT
- x - SPIKE
- ⊕ - Cross in conc. found

I, HAROLD H. KOLB, DO HEREBY CERTIFY THAT I HAVE
SURVEYED THE PROPERTY HEREON DESCRIBED ACCORDING
TO THE OFFICIAL RECORDS, AND THAT THE PLAT HEREON
IS A CORRECT REPRESENTATION OF THE LOT LINES.

Harold H. Kolb

HAROLD H. KOLB

WISCONSIN REGISTERED LAND SURVEYOR, S-187

DATE November 19, 1964

XFH-04

2-440