


**SURVEYING & SUBDIVIDING
DELVAN, WISCONSIN**

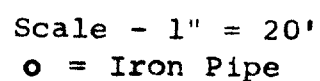

I, George T. Dunham, Surveyor, certify that I have surveyed the property described as follows,
Lot 4 in Block 4 of Rishurst Addition to the City of Delavan,
Walworth County, Wisconsin,
and that the above plat is an accurate survey and a true representation thereof and correctly shows the exterior boundary lines and location of buildings on said property and the correct measurements thereof.
September 9, 1972

A circular seal with a dotted border. The text "WISCONSIN" is at the top and "LAND SURVEYOR" is at the bottom, both following the curve of the border. In the center, the text "GEORGE T. DUNHAM" is written in a bold, sans-serif font, with "DELAVAN, WIS." below it. Two small five-pointed stars are positioned on the left and right sides of the seal, separating the top and bottom text.