
00

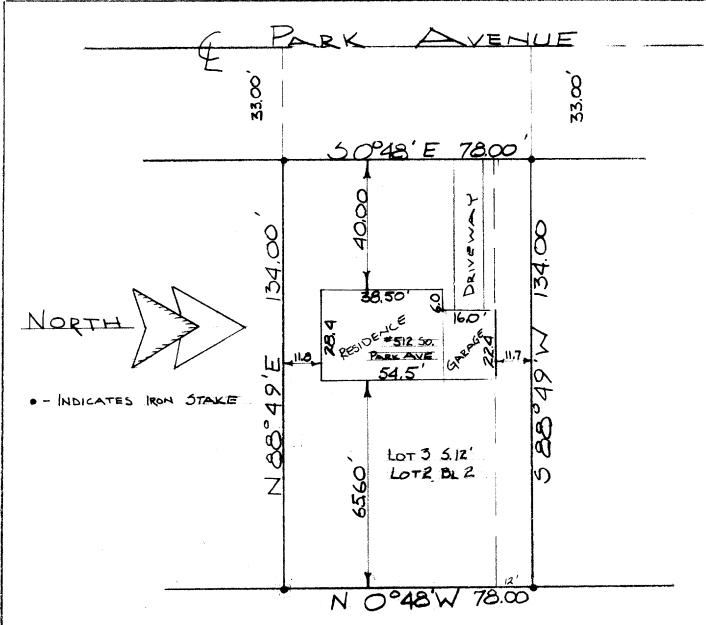

DESCRIPTION: The South 12.00 feet of Let 2, and all of Let 3, in Block 2 of the South Park Subdivision, lecated in the ## of the SW to of Section 17 and in the NE to of the NW to of Section 20, Town 2 North, Range 16 East, Walworth County, Wiscensin.

CERTIFICATE: I, James F. Biagi, surveyor, do hereby certify that I have surveyed the property hereon described, and that the location of all the improvements are as shown on the above drawing.

August 20, 1960

James F. Biagi RIS 272