


**SURVEYING & SUBDIVIDING
DELAVER, WISCONSIN**

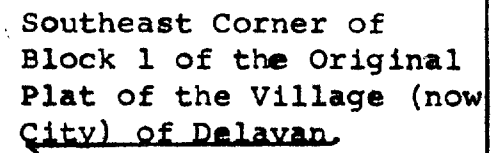

(By Description 4 Rods)

66.31

TEST

105-68

14.4

0

13.7

HOUSE

15.7

PORCH

66.31

(By description 4 Rods)

FOURTH

M C D O W E L L

S T R E E T

Scale - 1" = 20'

O = Iron Pipe

● = Concrete Monument

X = Cross in Sidewalk

STATE OF WISCONSIN)
COUNTY OF WALWORTH) SS

described as follows,

Beginning at a point 15 rods East of the Southeast corner of Block 1 of the Village (now City) of Delavan, Walworth County, Wisconsin according to the plat thereof recorded in the office of the Register of Deeds for Walworth County, Wisconsin and running North 63.50 feet; East 4 rods; South 63.50 feet; West 4 rods to the place of beginning,

and the above map is a true representation thereof and shows the size and location of the property, its exterior boundaries, the location and dimensions of all structures thereon, apparent easements and that there are no visible encroachments.

June 13, 1974

George T. Dunham
George T. Dunham, Surveyor

