
## GEORGE T. DUNHAM SURVEYING & SURDIVIDING DELAYAN, WISCONSIN

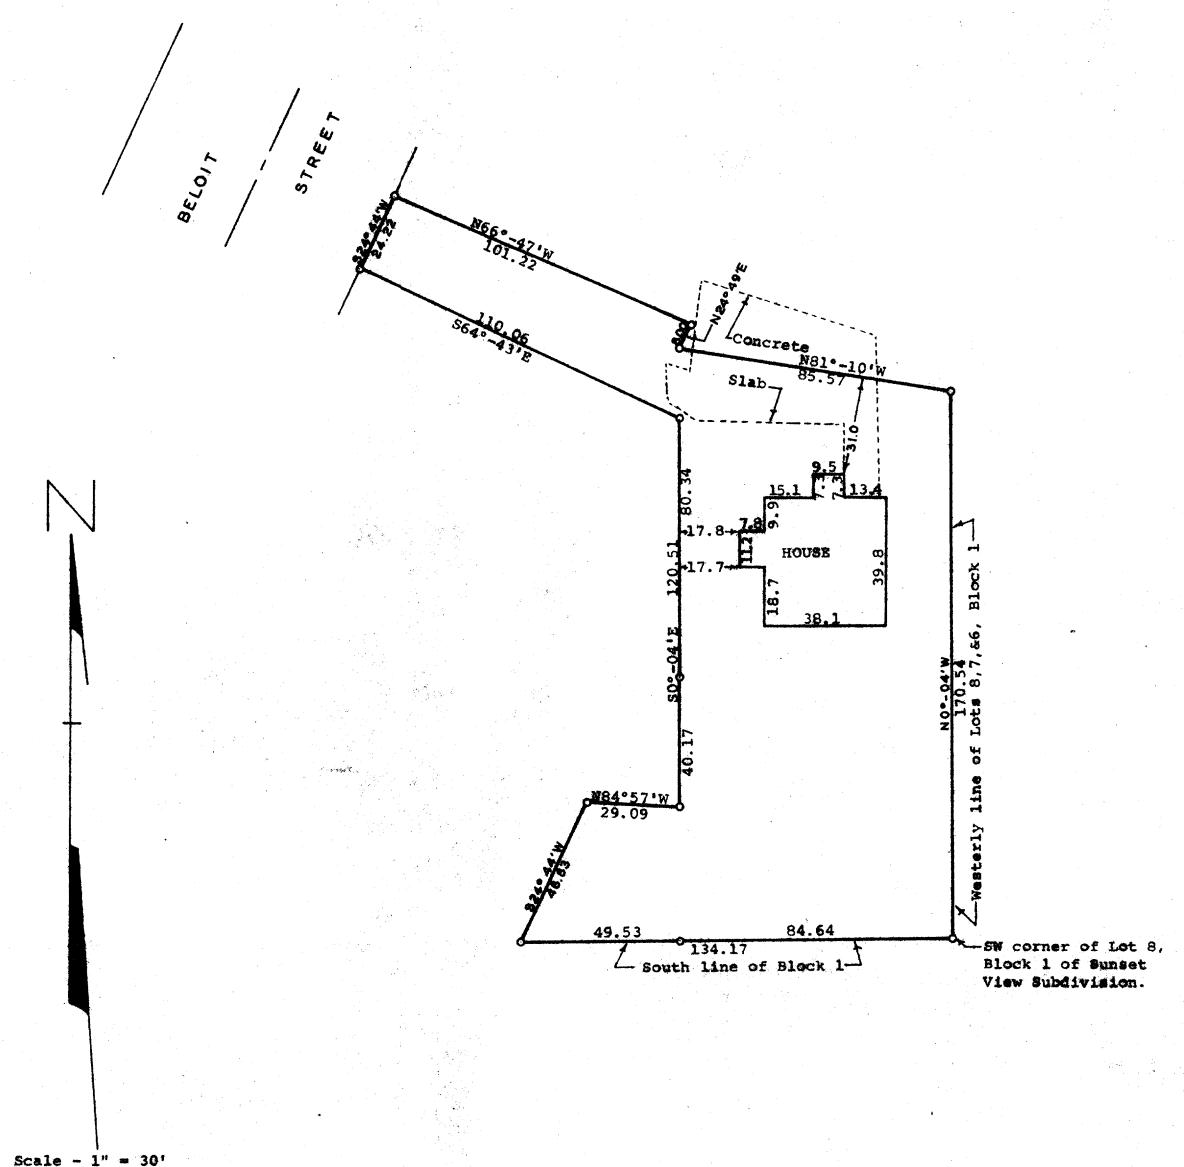

O = Iron Pipe

May 21, 1976

STATE OF WISCONSIN) SS COUNTY OF WALWORTH)


I, George T. Dunham, Surveyor, certify that I have surveyed the property described as follows,

A parcel of land commending at the Southwest corner of Lot 8 in Block 1 of Sunget View Subdivision of the City of Delavan; thence NO°-04'W along the Westerly lines of Lot 8, 7 and 6 of said Block 1, 170.54 feet to an iron pipe marking the Southeasterly corner of lands sold to William Byron Leek and wife by deed recorded in Volume 444 of Deeds on page 377 as Dec. No. 444886; thence NS1°-10'W, 85.57 feet; thence N24°-49'E, 8.00 feet; thence N65°-47'W 101.22 feet to Beleit Street; thence S24°-44'W along Beloit Street, 24.22 feet to the Northeast corner of premises sold to Lawrence A. Evans and wife by deed redorded in Volume 411 of Deeds on page 211 as Doc. No. 423629; thence S64°-43'E 110.06 feet to a point; thence S0°-04'E 126.51 feet; thence S64°-43'E 110.06 feet; thence S24°-44'W, 48.83 feet to the South line of Block 1, 134.17feet to the place of beginning.

and the above map is a true representation thereof and shows the size and location of the property, its exterior boundaries; the location and dimensions of all structures thereom, fances, apparent essentials and readways and visible encreachments, if any.

This survey is made for the exclusive use of the present owners of the property, and also those who purchase, mertgage, or quarantee the title thereto within one (1) year from date heree?; and as to them I herrant the accuracy of said survey and map.

George Jr. Dunham, Surveyor

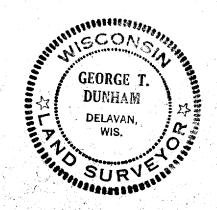

% A T 19-6168 250-675