
#115-66

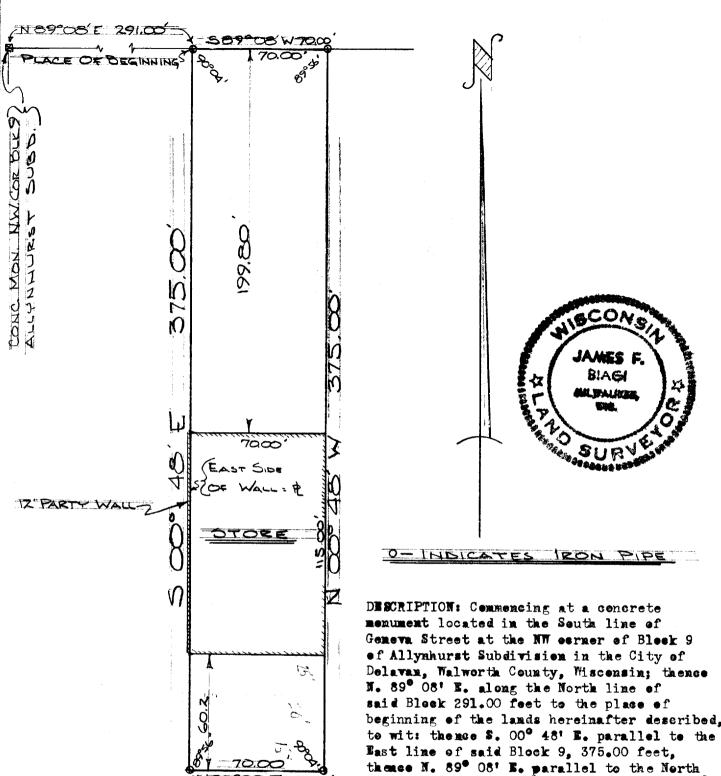

beginning of the lands hereinafter described, line of Block 9, 70.00 feet, thence N. 00° 48' W. parallel to the East line of said Block 9, 375.00 feet to the North line of said Bleck9, themse S. 89° 08' W. 70.00 feet to the place of beginning.

CERTIFICATE: I, James F. Biagi, surveyer, do hereby certify that i have surveyed the property hereon described and the less tion of the improvements are as Skowa.

August 13, 1966.

2-54B