
## DUNHAM SURVEYING, S.C. SURVEYING & SUBDIVIDING DELAVAN, WISCONSIN 53115

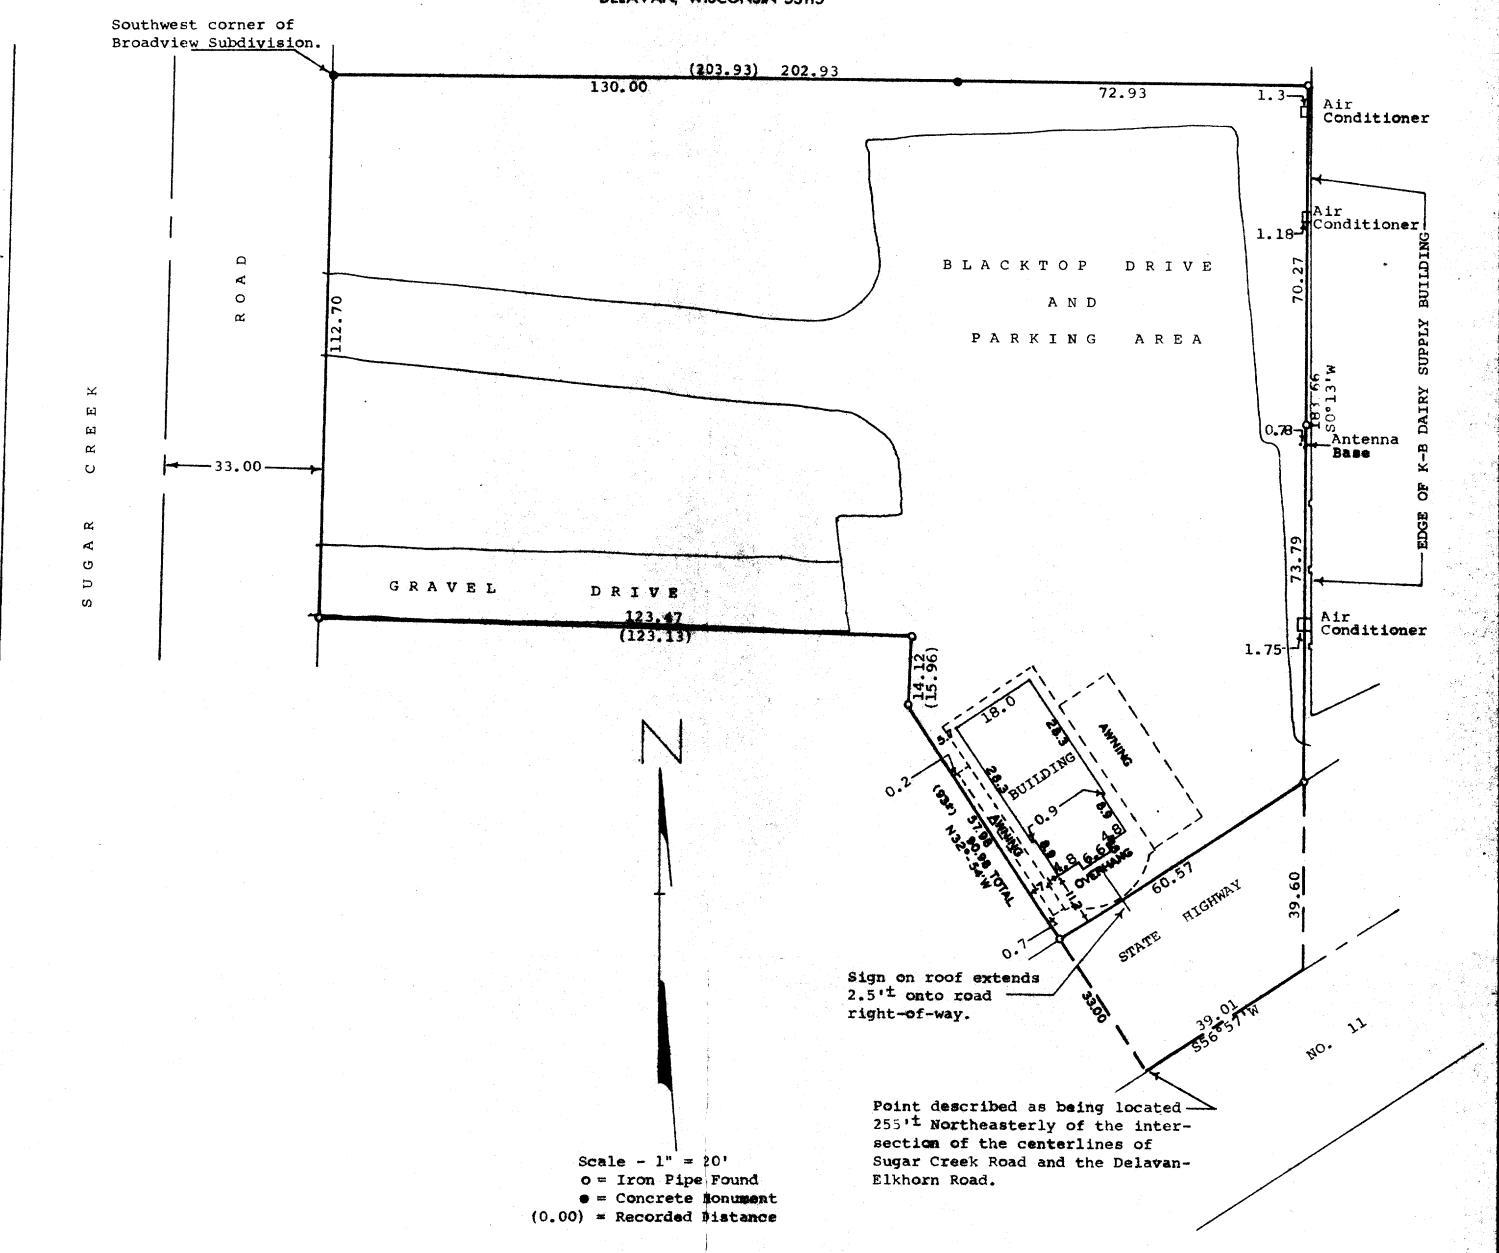

STATE OF WISCONSIN) COUNTY OF WALWORTH) SS

December 19, 1977

I, James M. Dunham, Surveyor, certify that I have surveyed the

property described as follows,

A parcel of land located in the Northeast & of Section 17, T2N, R16E, City of Delavam, Walworth County, Wisconsin, described as follows: Beginning at the southwest corner of Broadview Subdivision; thence Easterly along the south line of said subdivision and the easterly extension of said line, 202.93 feet to an iron pipe (previously described as 203.93 feet); thence 50°-13'w, 183.66 fact to the centerline of State Trunk Highway No. 11; thence 556°-57'W along said center ine 39.01 feet to a point described as being located 255 feet more or less Northeasterly of the intersection of the centerlines of Sugar Creek Road and the Delavan-Elkhorn Road; thence N32°-54'W 90.98 feet (previously described as 93 feet); thence Northerly 14.12 feet (previously described as 15.96 feet) to a point located 123,47 feet East of the east line of Sugar Creek Road; thence Westerly 123,47 feet (previously described as 123.13 feet) to a point on the east line of said Sugar Creek Road located 112.70 feet south of the place of beginning; thence North along the east line of said Road 112.70 feet to the place of beginning. ALSO beginning at the southwest corner of said Broadview Subdivision; thence South along the east edge of Sugar Creek Road 112.70 feet to an iron pipe; thence Westerly 33,00 feet to the centerline of said road; thence North along said centerline to a point located 33.00 feet west of the place of beginning: thence East 33.00 feet to the place of beginning,

and the above map is a true representation thereof and shows the size and location of the property, its exterior boundaries, the location and dimensions of all structures thereon, fences, apparent easements and roadways and visible encroachments, if any.

James M. Dunham, Surveyor

