

MORTGAGE INSPECTION SURVEY

LOCATED IN ALLYNHURST SUBDIVISION IN THE CITY OF DELAVAN
WALWORTH COUNTY, WISCONSIN

Note: This is not a "Property Survey" as defined in Section A-E 5.01 of the Wisconsin Administrative Code.



MADISON DRIVE

66' WIDE

SELLER: Michael Waling
BUYER: James Miller
ADDRESS: 609 Madison Drive
City of Delavan
WORK ORDERED BY: Gayle Albrecht for
Waukesha Savings & Loan

Lot 15

Lot 16

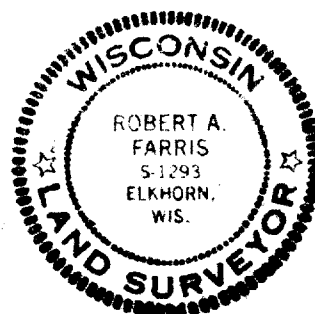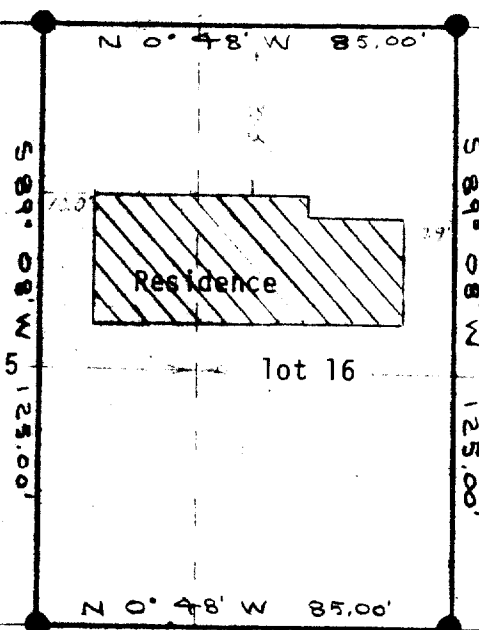

● = IRON PIPE SURVEY MONUMENT FOUND

SCALE: 1"=40'

LEGAL DESCRIPTION:

The North 32 feet of Lot 15 and the South 53 feet of Lot 16, Block 5 of Allynhurst Sub-division, located in the City of Delavan, Walworth County, Wisconsin.

I hereby certify that this map is a true and accurate representation of the lot lines and the buildings located thereon to the best of my knowledge and belief.

Dated this 18th day of June, 1978

Robert A. Farris S- 1293

FARRIS, HANSEN & COOPER, INC.
715 W. Walworth St. P.O. Box 487
Elkhorn, WI 53121

Job No. 1349

AS-69

2-5724