
DUNHAM SURVEYING, S.C. SURVEYING & SUBDIVIDING DELAVAN, WISCONSIN 53115

20' Alley (Vacated)

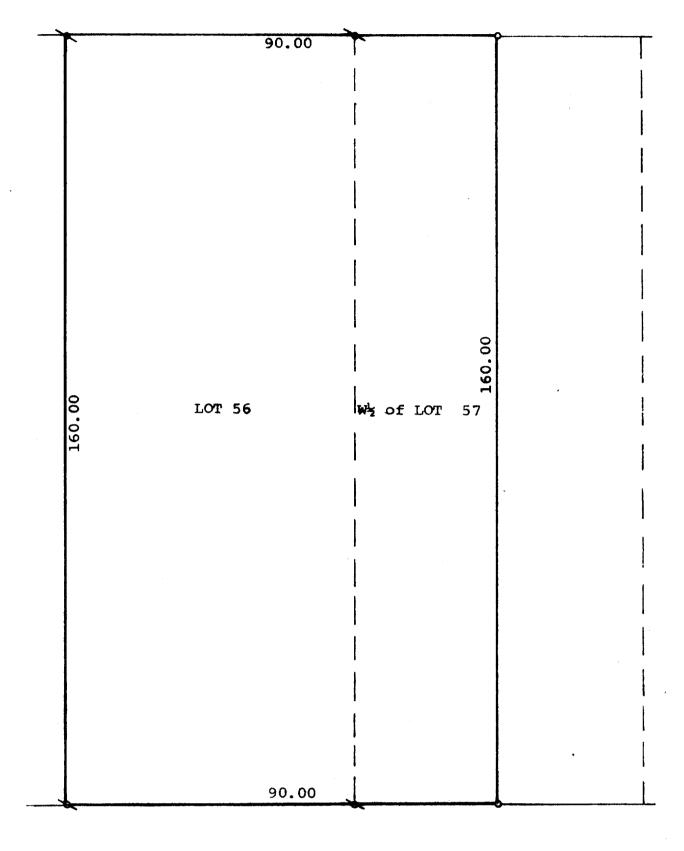

= iron pipe rouna o = Iron pipe set

FRANKLIN

STREET

STATE OF WISCONSIN) SS COUNTY OF WALWORTH)

I, James M. Dunham, Surveyor, certify that I have surveyed


the property described as follows,

Lot 56 and the West 2 of Lot 57 of Mar-Del Estates, a subdivision located in the city of Delavan, Walworth County, Wisconsin, and the above map is a true representation thereof and shows the size and location of the property, its exterior boundaries, the location and dimensions of all structures thereon, fences, apparent easements and roadways and visible encroachments, if any.

This survey is made for the exclusive use of the present owners of the property, and also those who purchase, mortgage, or guarantee the title thereto within one (1) year from date hereof; and as to them I warrant the accuracy of said survey and map.

June 28, 1978

James M. Dunham, Surveyor

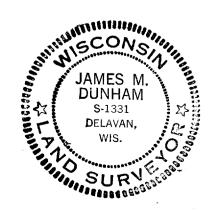

K & E 10-9149 250-9-76