


DUNHAM SURVEYING, S. C.
SURVEYING & SUBDIVIDING
DELAVAN, WISCONSIN 53115

FOURTH

STREET

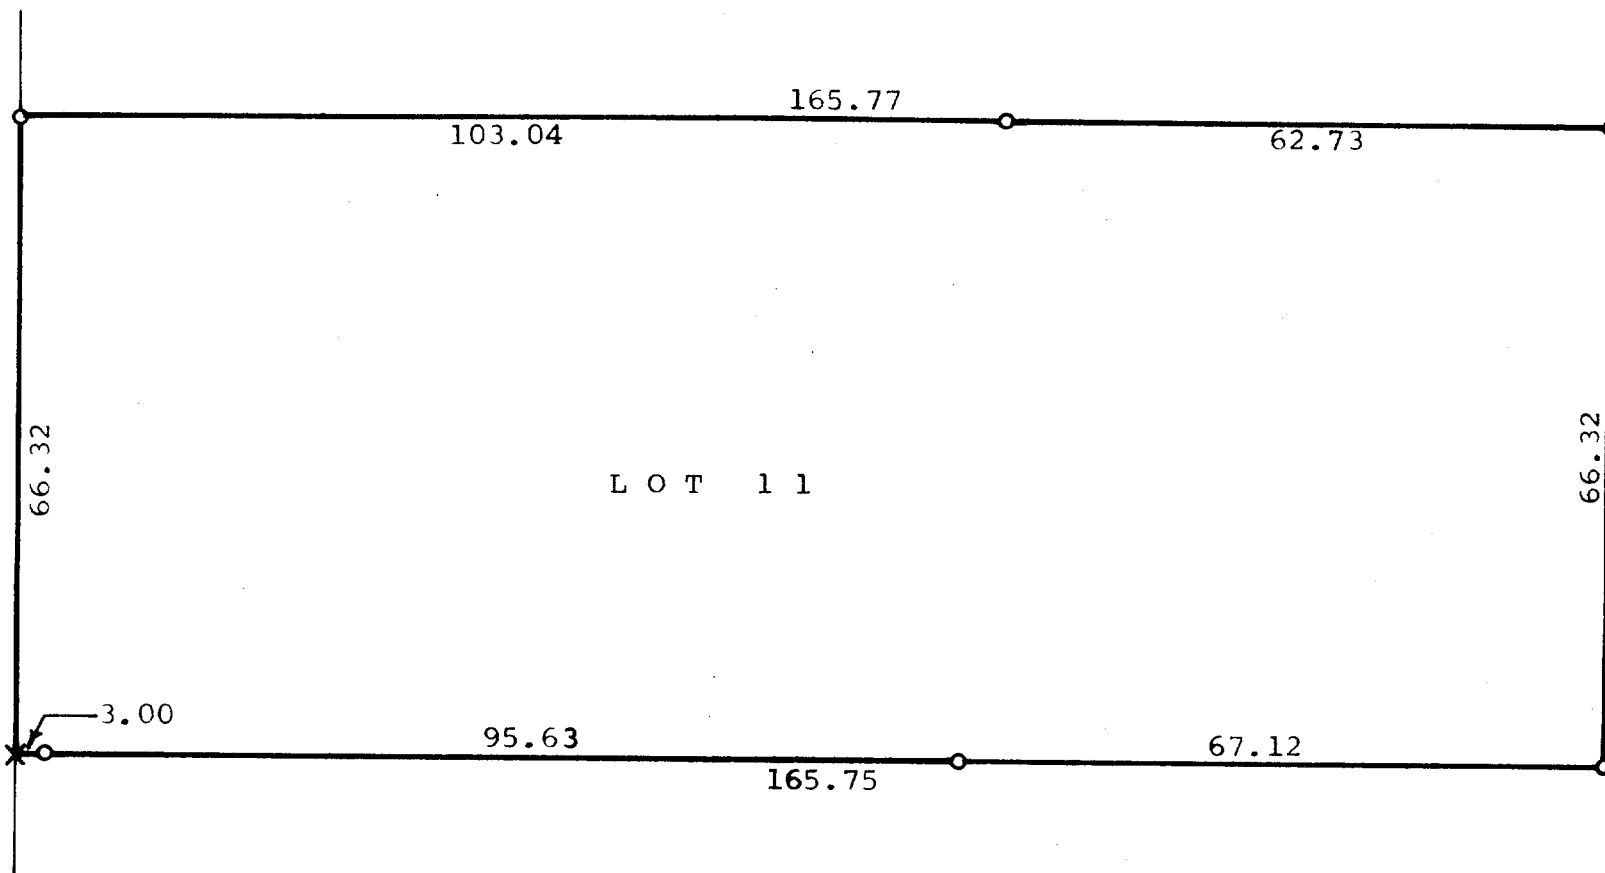

N

Scale - 1" = 20'
X = Cross in Sidewalk
O = Iron Pipe

Plat of survey of:
Lot 11, Block 1 of Passage, Aram, and Downie Addition to the
Village (now City) of Delavan, Walworth County, Wisconsin.
April 24, 1978

James M. Dunham
James M. Dunham, Surveyor

