
DUNHAM SURVEYING, S.C. SURVEYING & SUBDIVIDING DELAYAN, WISCONSIN 53115

LAUREL

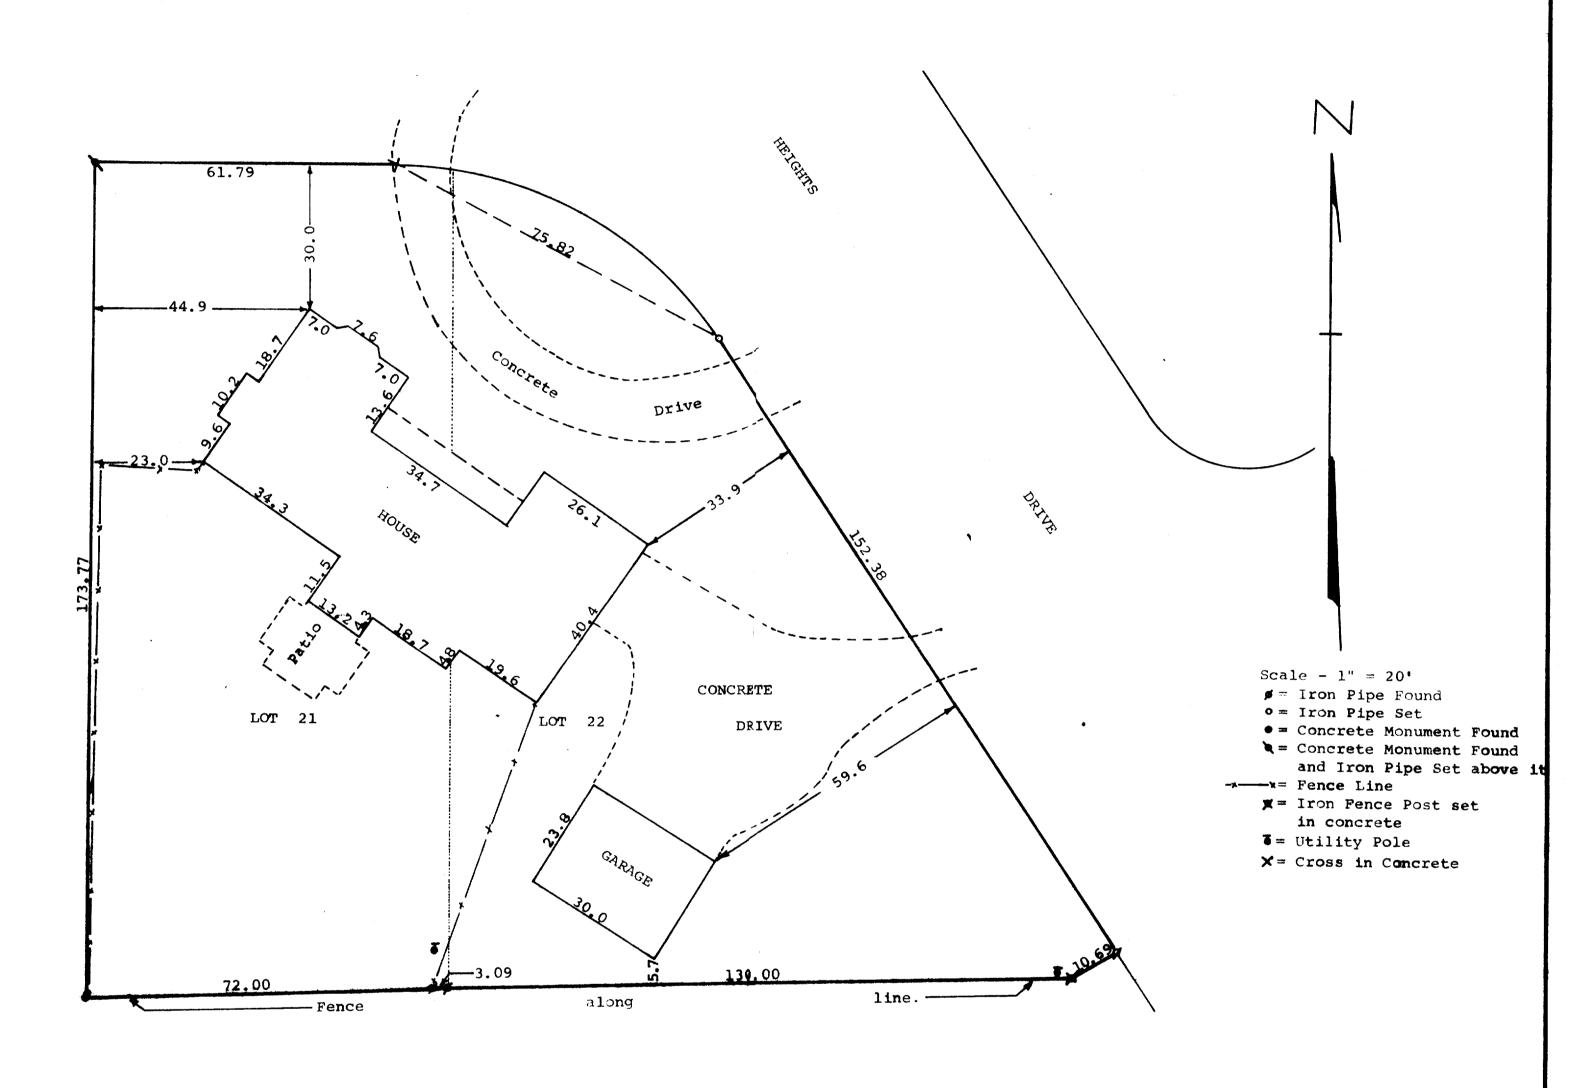

STATE OF WISCONSIN) SS COUNTY OF WALWORTH)

I, James M. Dunham, Surveyor, certify that I have surveyed the

property described as follows:

Lots 21 and 22 in Laurel Heights, a subdivision located in the City of Delavan, Walworth County, Wisconsin, the plat of which is recorded in Volume 12 of Plats on Page 34, Walworth County Records,

and that the above map is a true representation thereof and shows the size and location of the property, its exterior boundaries, the location of all visible structures and dimensions of all principal buildings thereon, boundary fences, apparent easements, roadways and visible encroachments, if any.

This survey is made for the use of thepresent owners of the property, and also those who purchase, mortgage, or guarantee the title thereto within one (1) year from date hereof. September 25, 1980

James M. Dunham, Surveyor

