
DUNHAM SURVEYING, S.C. SURVEYING & SUBDIVIDING DELAYAN, WISCONSIN 53115

WASHINGTON

STREET

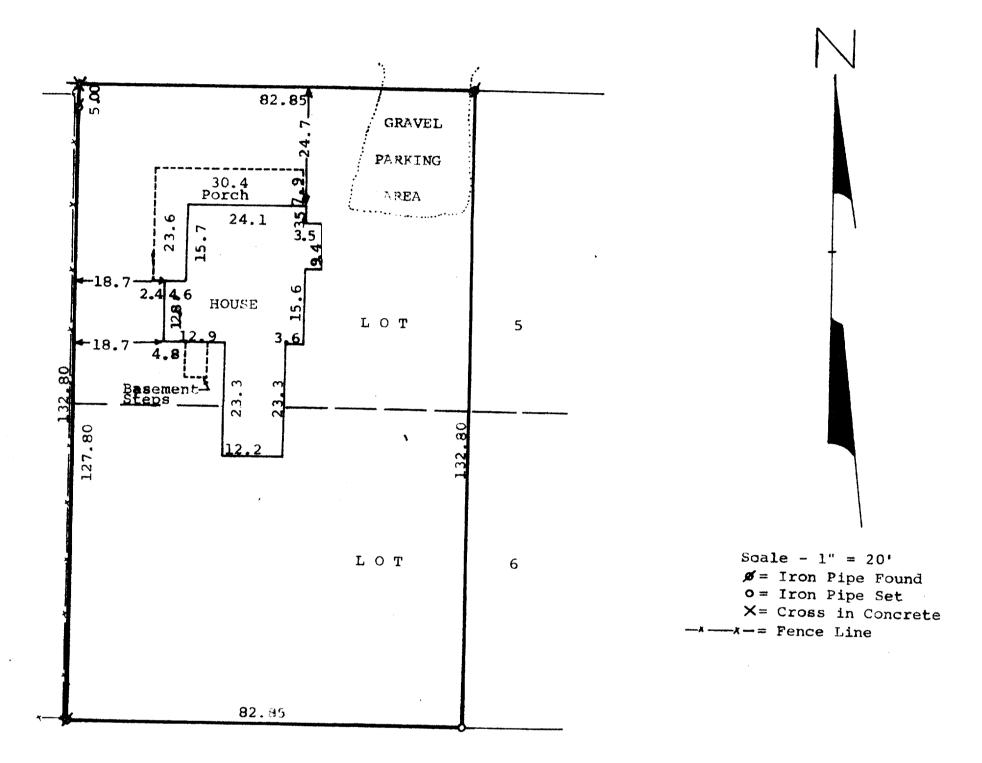

STATE OF WISCONSIN) COUNTY OF WALWORTH) SS

K & K 10-5185 250-9-74

I, James M. Dunham, Surveyor, certify that I have surveyed the

property described as follows,

The West of Lots 5 and 6, Block 2 of Passage, Aram, and Downies Addition to the City of Delavan, Walworth County, Wisconsin, and that the above map is a true representation thereof and shows the size and location of the property, its exterior boundaries, the location of all visible structures and dimensions of all principal buildings thereon, boundary fences, apparent easements, roadways and visible encroachments, if any.

This survey is made for the use of the present owners of the property, and also those who purchase, mortgage, or guarantee the title thereto within one (1) year from date hereof.

July 19, 1979

Janes 4/1 Dunkan

