


DUNHAM SURVEYING, S.C.
SURVEYING & SUBDIVIDING
DELAVER, WISCONSIN 53115

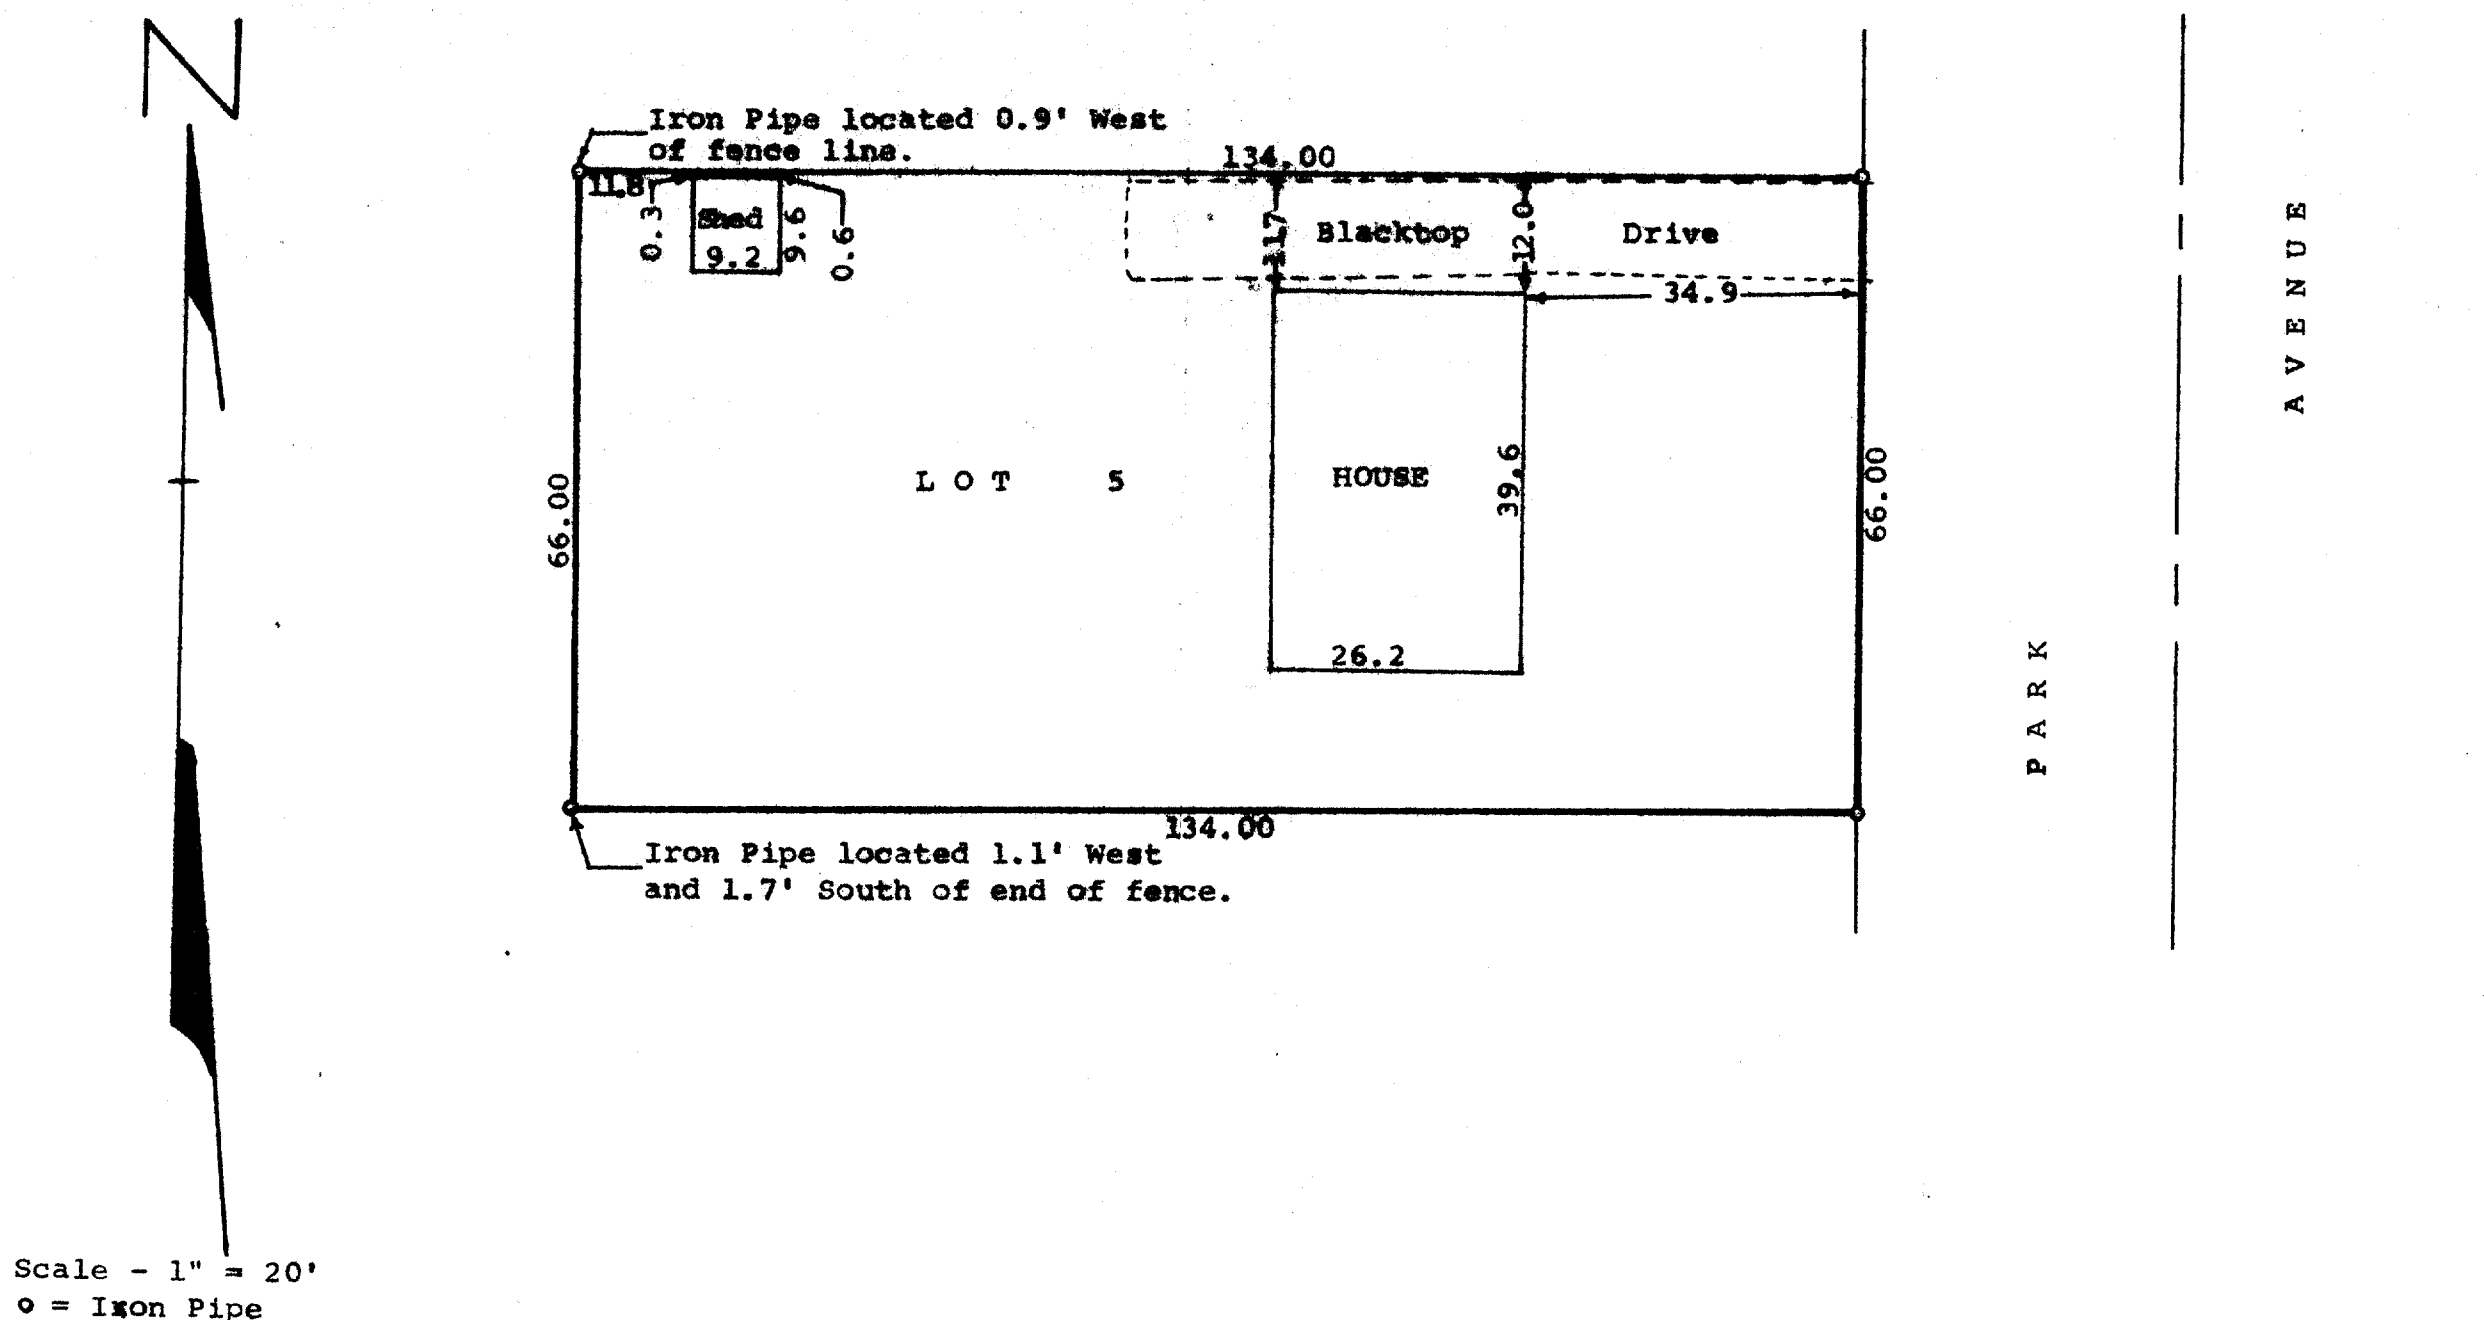

STATE OF WISCONSIN)
COUNTY OF WALWORTH)

I, George T. Dunham, Surveyor, certify that I have surveyed the property described as follows,

Lot 5, Block 1 of South Park Subdivision, located in the Southeast $\frac{1}{4}$ of the Southwest $\frac{1}{4}$ of Section 17 and in the Northeast $\frac{1}{4}$ of the Northwest $\frac{1}{4}$ of Section 20, T 2 N, R 16 E, City of Delavan, Walworth County, Wisconsin.

and that the above map is a true representation thereof and shows the size and location of the property, its exterior boundaries, the location of all visible structures and dimensions of all principal buildings thereon, boundary fences, apparent easements, roadways and visible encroachments, if any.

This survey is made for the use of the present owners of the property and also those who purchase, mortgage, or guarantee the title thereto within one (1) year from date hereof.

April 7, 1981

George T. Dunham
George T. Dunham, Surveyor

