
KOLB LAND CONSULTING, INC.

LAND SURVEYING . SUBDIVIDING . LAND PLANNING

LAKE GENEVA, WISCONSIN 53147

COTTON WOOD STREET 66 WIDE

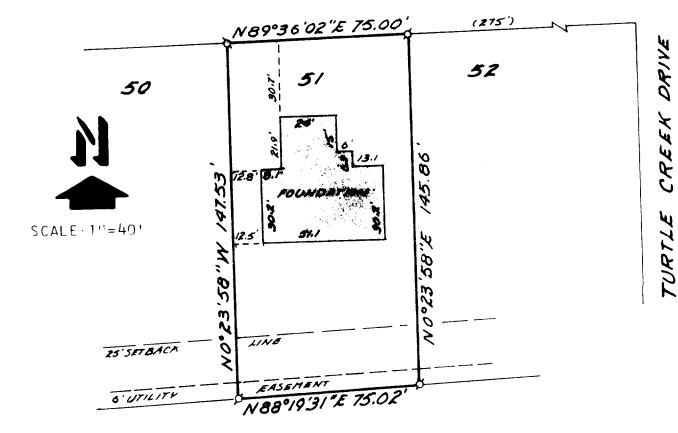

66'WIDE CREEK ROAD

PLAT OF SURVEY OF

LOT 51, TURTLE CREEK, A SUBDIVISION LOCATED IN THE SOUTH.
EAST 1/4 OF SECTION 13, T 2 N, R 15 E, CITY OF DELAVAN, WALWORTH COUNTY, WISCONSIN.

ORDERED BY: ANCHOR SAVINGS & LOAN ASSOCIATION

P.O. BOX 346

DELAVAN, WI. 53115 NOTE: BEARINGS ARE ASSUMED AS SHOWN ON THE RECORDED PLAT

OF TURTLE CREEK.

LEGEND Ø IRON PIPE FOUND (7) AS RECORDED

> I. HAROLD H. KOLE, DO HERREY CERTIFY THAT I HAVE SURVEYED THE PROPERTY HEREON DESCRIPED ACCORDING TO THE OFFICIAL RECORDS, AND THAT THE PLAT HEREON IS A CORRECT REPRESENTATION OF THE LOT LINES AND THE PRINCIPAL LINES OF THE BUILDINGS THEREON TO THE BEST OF MY KNOWLEDGE AND PELIFF.

HAROLD H. KOLB WISCONSIN REGISTERED LAND SURVEYOR, S- 187 JUNE 12, 1984

-669-k

D-xTC-51