


DUNHAM SURVEYING, S.C.  
SURVEYING & SUBDIVIDING  
DELAVAN, WISCONSIN 53115



Scale - 1" = 20'  
 1" = 1" Iron Pipe Found  
 3/4" = 3/4" Iron Pipe Found

Bearings referenced to the West  
 Line of 7th Street with the  
 assumed bearing of North.

Survey ordered by:  
 Century 21, Skandia Realty  
 312 South 7th Street  
 Delavan, WI 53115

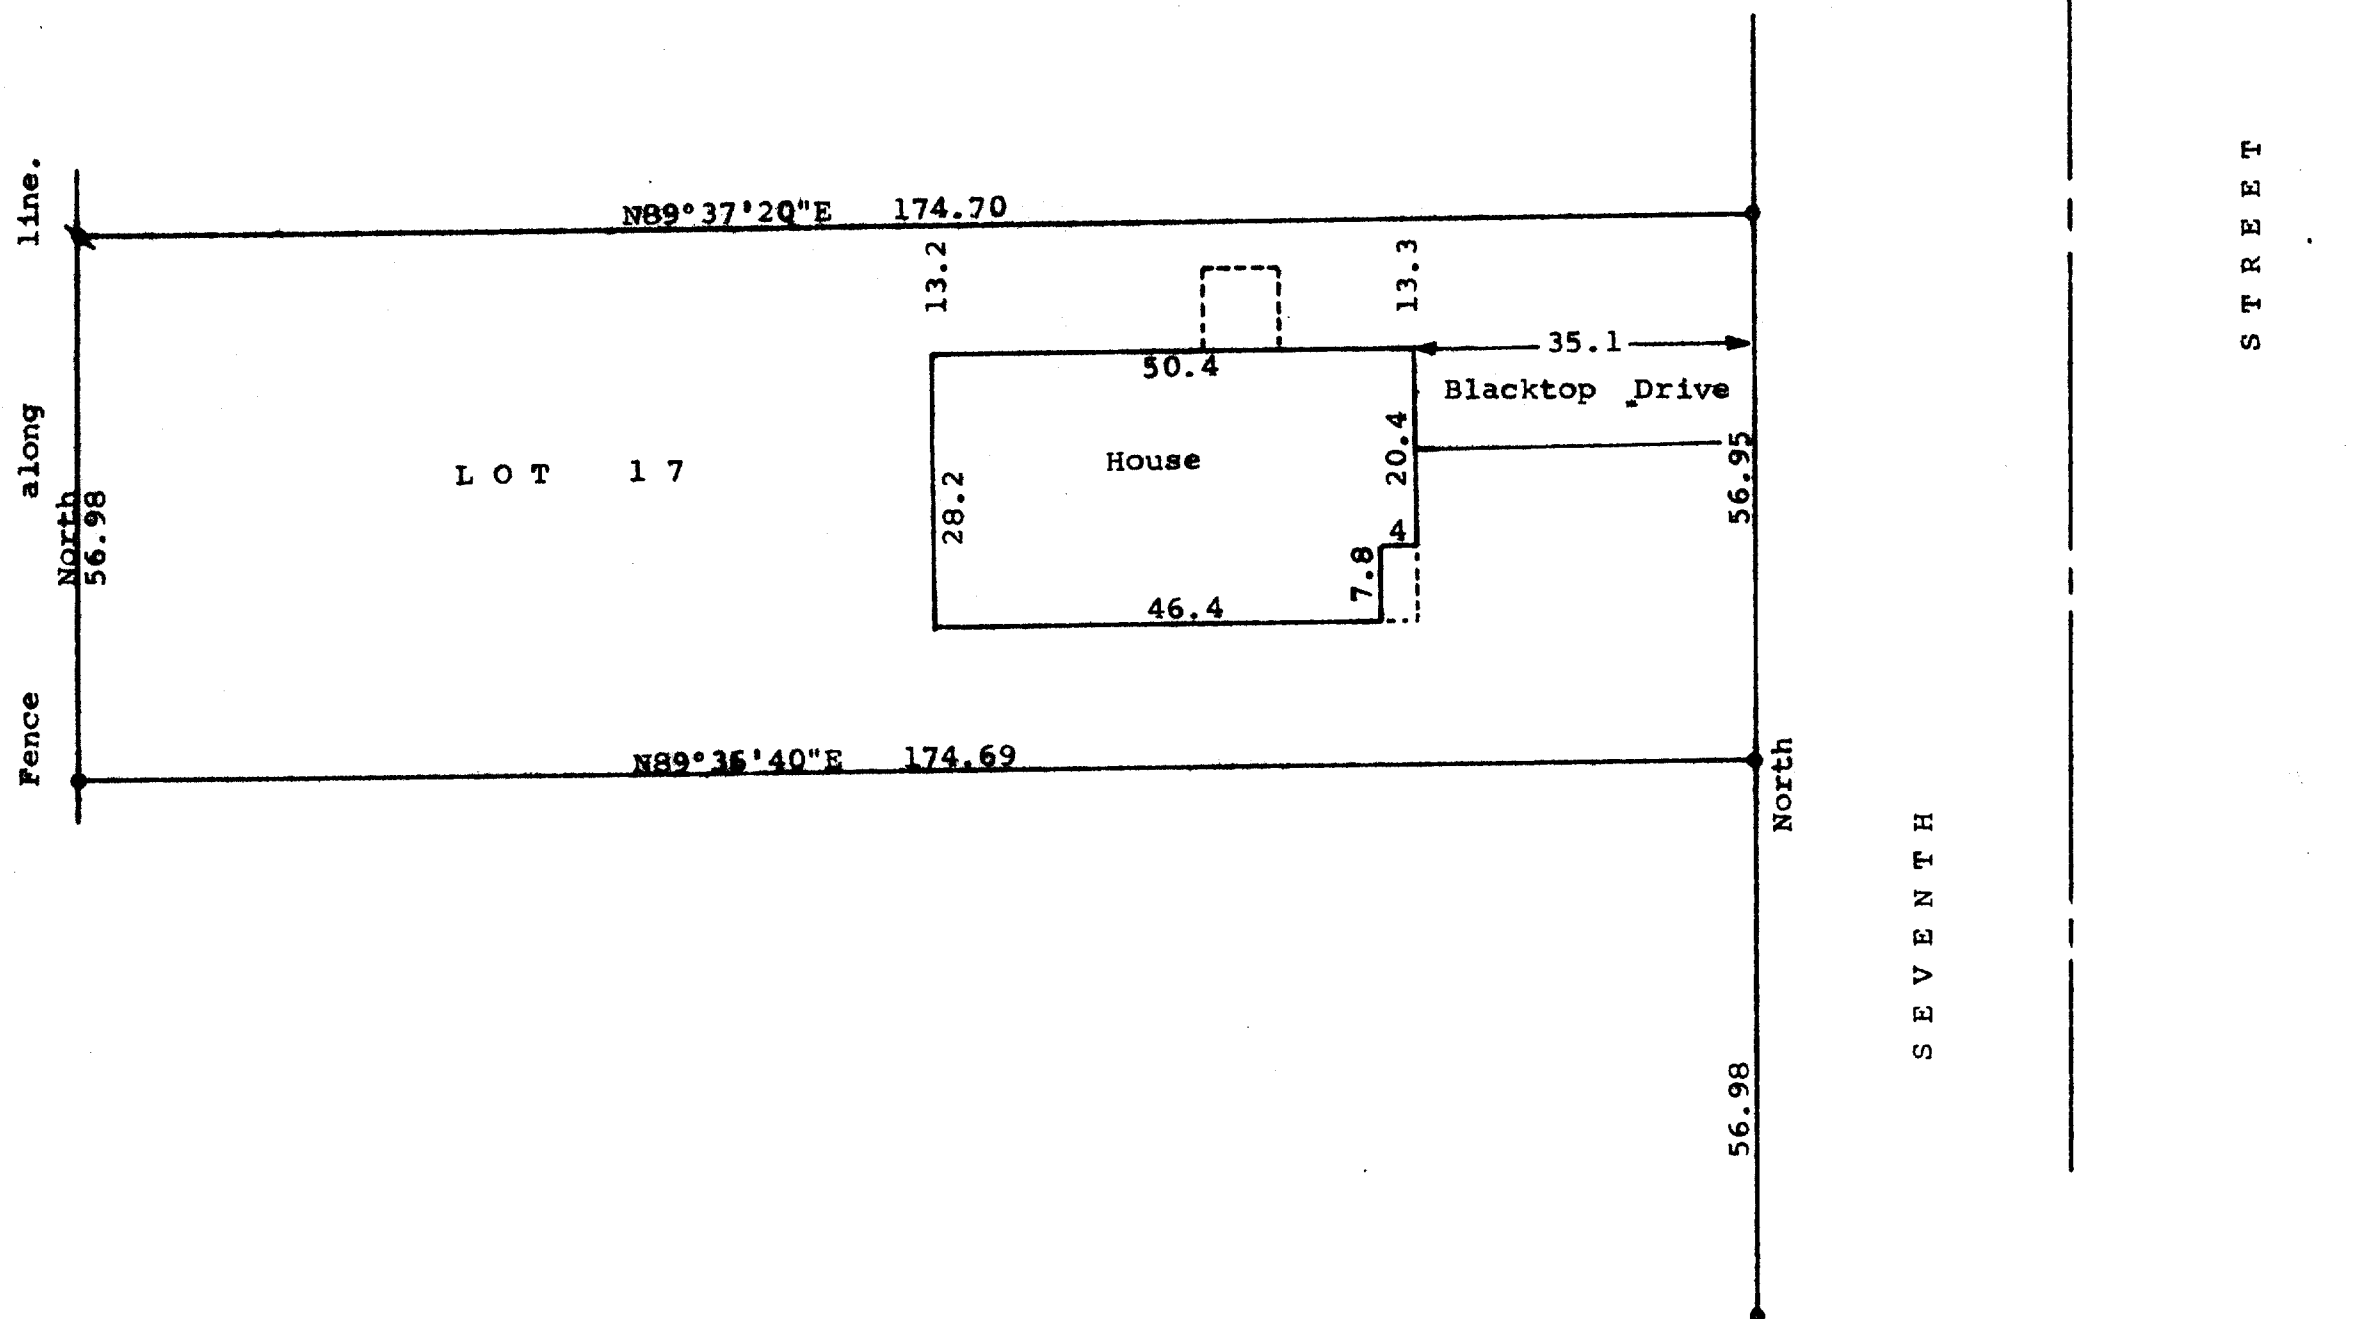

STATE OF WISCONSIN)  
 COUNTY OF WALWORTH) SS

I, Richard C. Schulz, Surveyor, certify that I have surveyed  
 the property described as follows,

Lot 17, Block 2 of Fairview Heights Addition, located in the  
 City of Delavan, Walworth County, Wisconsin,

and that the map shown hereon is a true representation thereof and shows the  
 size and location of the property, its exterior boundaries, the location of  
 all visible structures and dimensions of all principal buildings thereon, boundary  
 fences, apparent easements, roadways and visible encroachments, if any, and  
 that I have surveyed the property hereon described according to the official  
 records, to the best of my knowledge and belief.

June 27, 1984.

Richard C. Schulz  
 Richard C. Schulz, Surveyor

