


STREET

SEVENTH

H O L L A N D

A V E N U E

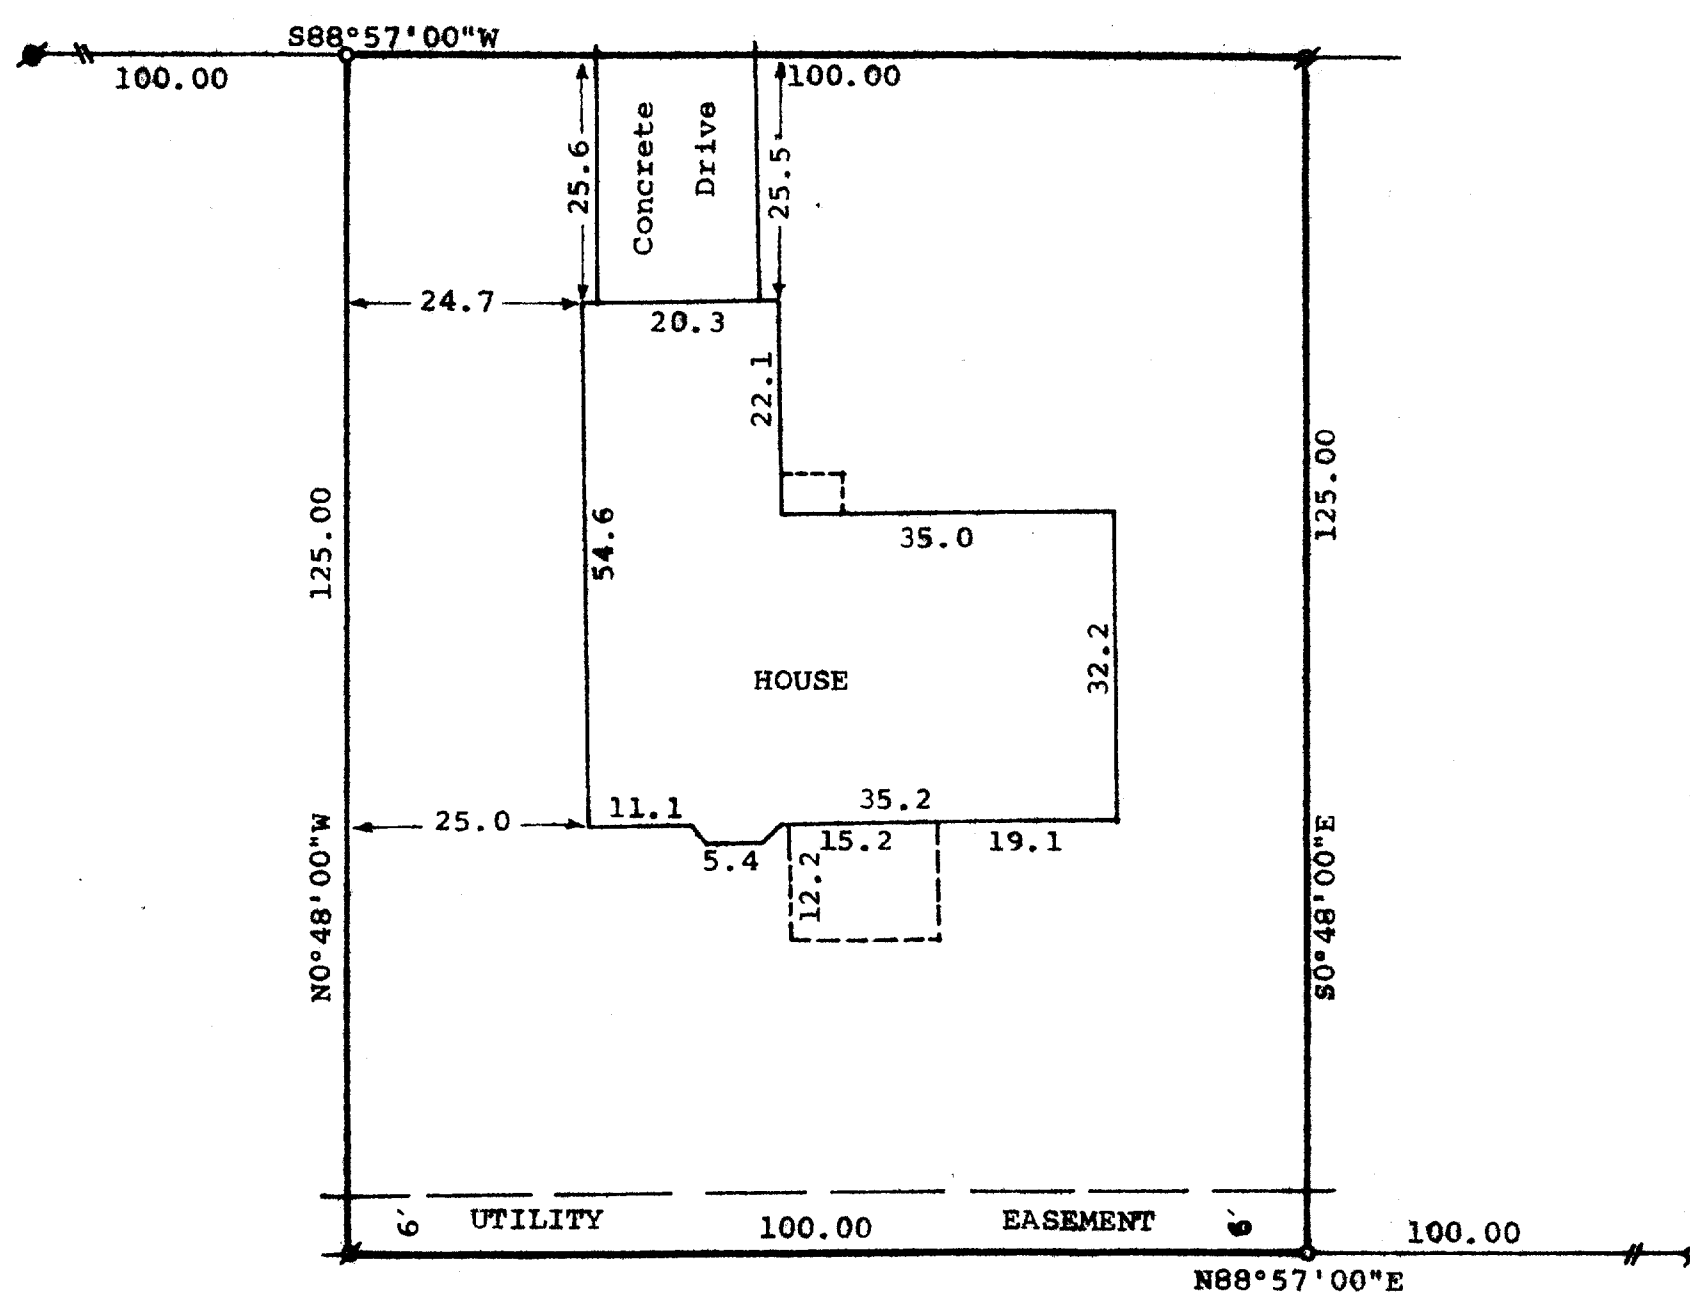

Scale - 1" = 20'
 Ø = 1" Iron Pipe Found
 o = 3/4" x 24" Iron Pipe Set
 Ø = 2" Iron Pipe Found
 Owners: Allen & Jean Logan
 702 Holland Avenue
 Delavan, Wisconsin 53115
 Bearings are those of record.

Richard C. Schulz
Richard C. Schulz, Surveyor

