
## DAVID F. ABELL WISCONSIN REGISTERED LAND SURVEYOR DELAVAN, WISCONSIN

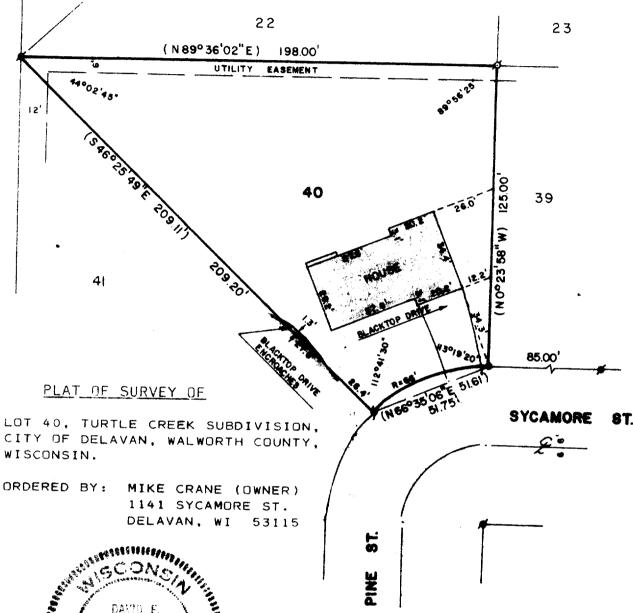

DAVID F.
About S. 1696
Denvan,
Wis.



SCALE - 1" =40'
LEGEND

# - IRON PIPE FOUND

- 3/4" IRON ROD SET

# - IRON ROD FOUND

()- RECORDED AS

I HEREBY CERTIFY THAT I HAVE SURVEYED THE ABOVE DESCRIBED PROPERTY AND THAT THE ABOVE MAP IS A TRUE REPRESENTATION THEREOF AND SHOWS THE SIZE AND LOCATION OF THE PROPERTY, ITS EXTERIOR BOUNDARIES, THE LOCATION OF ALL VISIBLE STRUCTURES AND DIMENSIONS OF ALL PRINCIPAL BUILDINGS THEREON, BOUNDARY FENCES, APPARENT EASEMENTS, ROADWAYS AND VISIBLE ENCROACHMENTS, IF ANY TO THE BEST OF MY KNOWLEDGE AND BELIEF.

THIS SURVEY IS MADE FOR THE USE OF THE PRESENT OWNERS OF THE PROPERTY, AND ALSO THOSE WHO PURCHASE, MORTGAGE, OR GUARANTEE THE TITLE THERETO WITHIN ONE (1) YEAR FROM DATE HEREOF.

David 7. abell

DAVID F. ABELL

WISCONSIN REGISTERED LAND SURVEYOR, S-1596

DATE april 25, 1985

27×

JOB NUMBER - 0006

2-695