
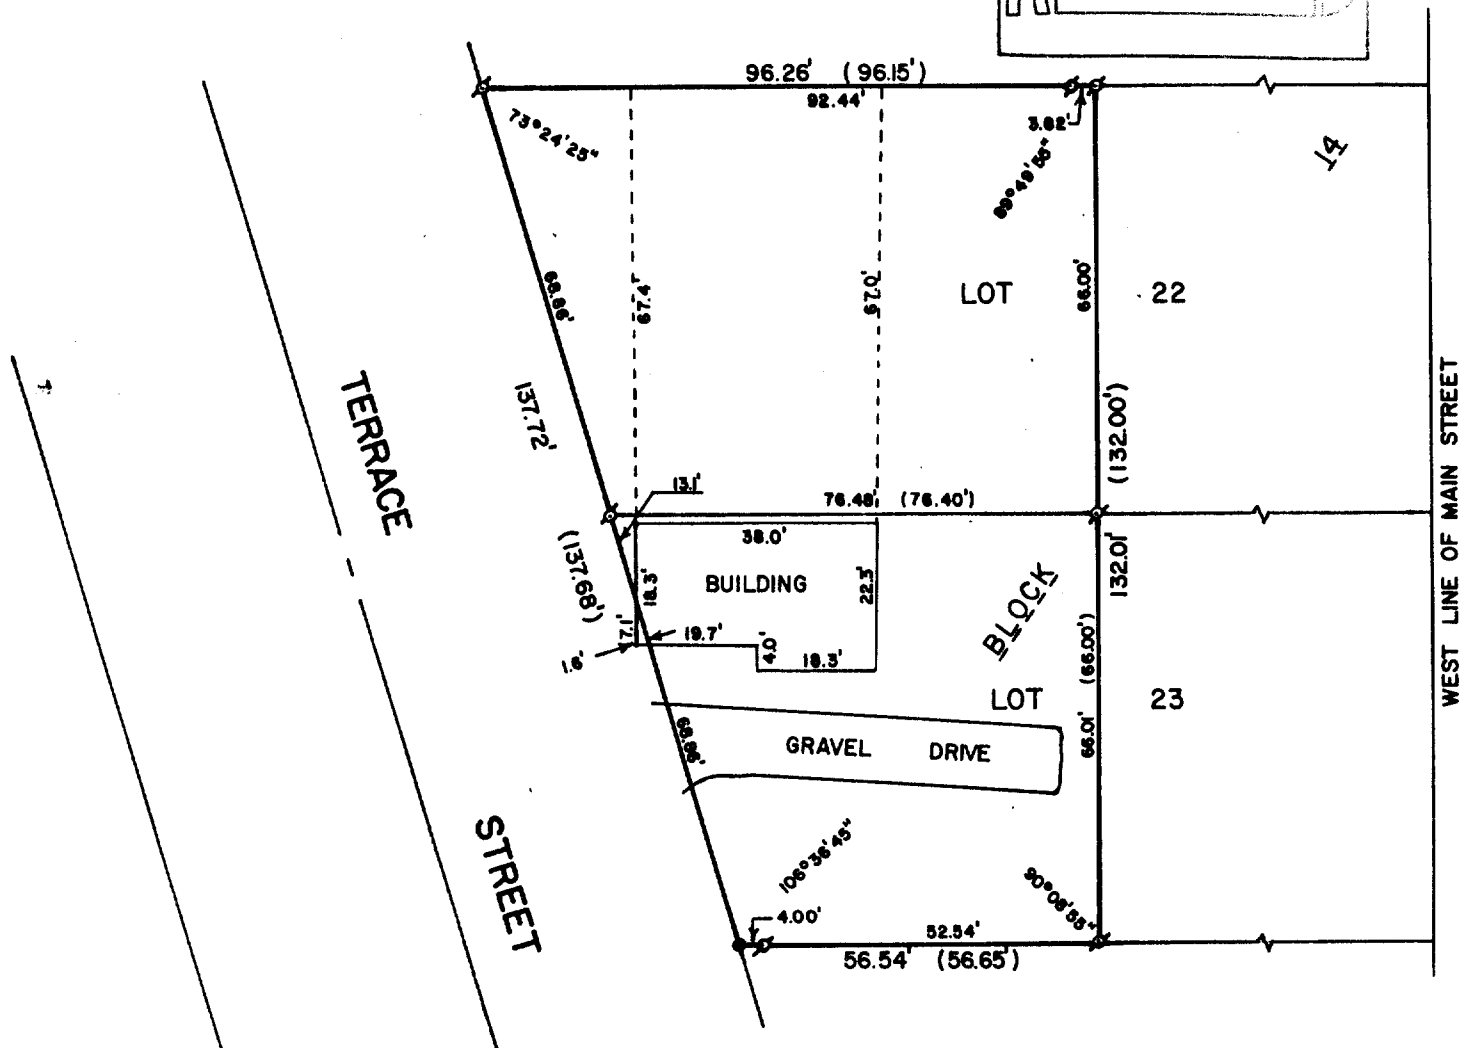



ABELL
SURVEYING & MAPPING
DELAVAN, WISCONSIN 53115
414-728-6737

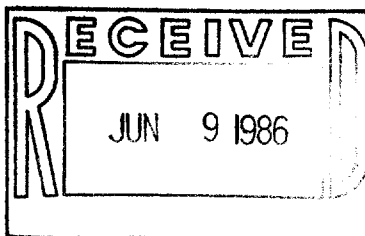

PLAT OF SURVEY OF

A PARCELED OF LAND LOCATED IN LOTS 22 AND 23, BLOCK 14 OF THE ORIGINAL PLAT, CITY OF DELAVAN, WALWORTH COUNTY, WISCONSIN, AND DESCRIBED AS FOLLOWS: BEGINNING AT THE NORTHWEST CORNER OF SAID LOT 22; THENCE EAST ALONG THE NORTH LINE OF SAID LOT 22, 96.15 FEET; THENCE SOUTH PARALLEL WITH THE WEST LINE OF MAIN STREET 66.00 FEET TO A POINT ON THE NORTH LINE OF SAID LOT 23 LOCATED 76.40 FEET EAST OF THE NORTHWEST CORNER OF SAID LOT 23; THENCE CONTINUE SOUTH PARALLEL WITH THE WITH THE WEST LINE OF MAIN STREET 66.00 FEET TO A POINT ON THE SOUTH LINE OF SAID LOT 23; THENCE WEST ALONG SAID SOUTH LINE 56.65 FEET TO THE EAST LINE OF TERRACE STREET; THENCE NORTHWESTERLY ALONG THE EAST LINE OF TERRACE STREET 137.68 FEET TO THE PLACE OF BEGINNING.

ORDERED BY: CENTURY 21 - SKANDIA REALTY
312 SOUTH 7th STREET
DELAVAN, WI 53115

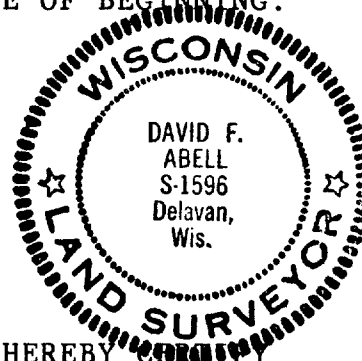

SCALE - 1"=30'

LEGEND

- - IRON PIPE FOUND
- - 3/4" IRON ROD SET
- () - RECORDED AS

I, DAVID F. ABELL, DO HEREBY
THAT I HAVE SURVEYED THE PROPERTY
HEREON DESCRIBED ACCORDING TO THE
OFFICIAL RECORDS, AND THAT THE PLAT
HEREON IS A CORRECT REPRESENTATION
OF THE PROPERTY LINES TO THE BEST OF
MY KNOWLEDGE AND BELIEF.

David F. Abell

DAVID F. ABELL
WISCONSIN REGISTERED LAND SURVEYOR, S-1596

DATE *May 10, 1986* JOB NUMBER - 86001

XOP-00157

2-700-A