

## DUNHAM SURVEYING, S.C. SURVEYING & SUBDIVIDING DELAVAN, WISCONSIN 53115

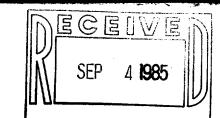

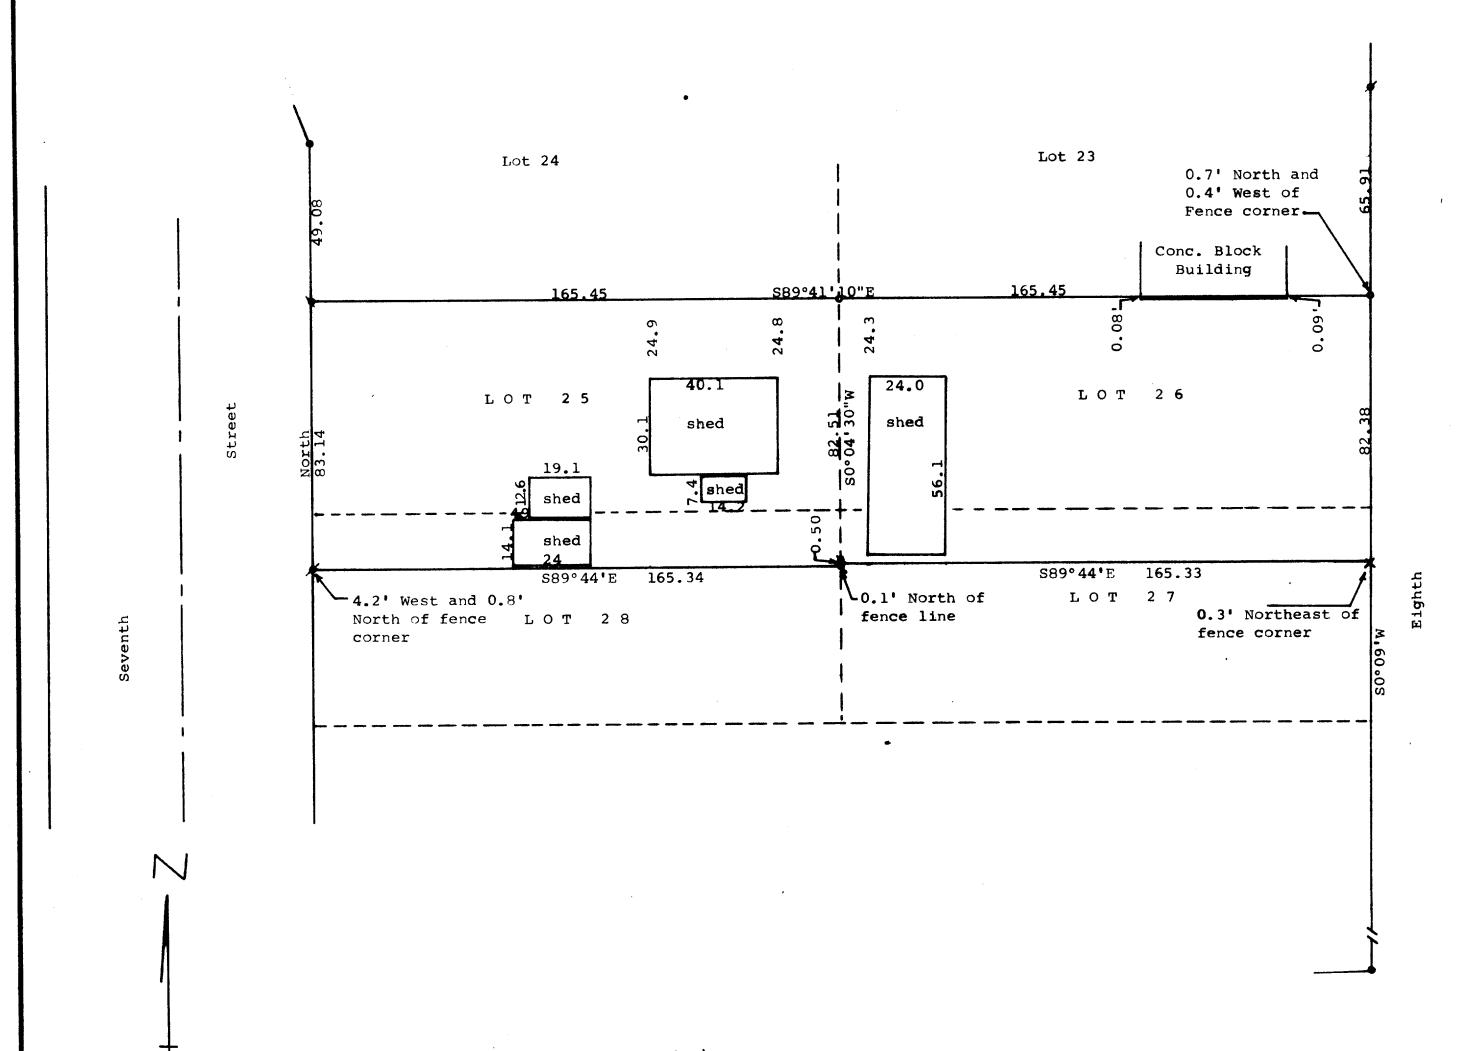

STATE OF WISCONSIN) SS COUNTY OF WALWORTH)

I, George T. Dunham, Surveyor, certify that I have surveyed the property described as follows:

Lot 25, Lot 26, the North 16.5 feet of Lot 27 and the North 17 feet of Lot 28, all located in Block 13 of Passage, Aram, and Downie Addition to the City of Delavan, Walworth County,

Wisconsin, and that the map shown above is a true representation thereof and shows the size and location of the property, its exterior boundaries, the location of all visible structures and dimensions of all principal buildings thereon, boundary fences, apparent easements, roadways and visible encroachments, if any, and that I have surveyed the property hereon described according to the official records to the best of my . knowledge and belief. August 7, 1985

Scale - 1" = 30'• = Concrete Mon. Found  $\beta = 3/4$ " Iron Pipe Found  $\circ$  = 3/4" X 24" Iron Pipe Set x = 3" X 18" Iron Pipe Set in concrete driveway Bearings referenced to the east line of Seventh Street with the assumed

bearing of North Owner: Emil Johnson 315 South 7th Street Delavan, WI 53115 = 1" Iron Pipe Found

X = Cross cut in concrete