


RECEIVED
MAY 5 1986
929

S T R E E T

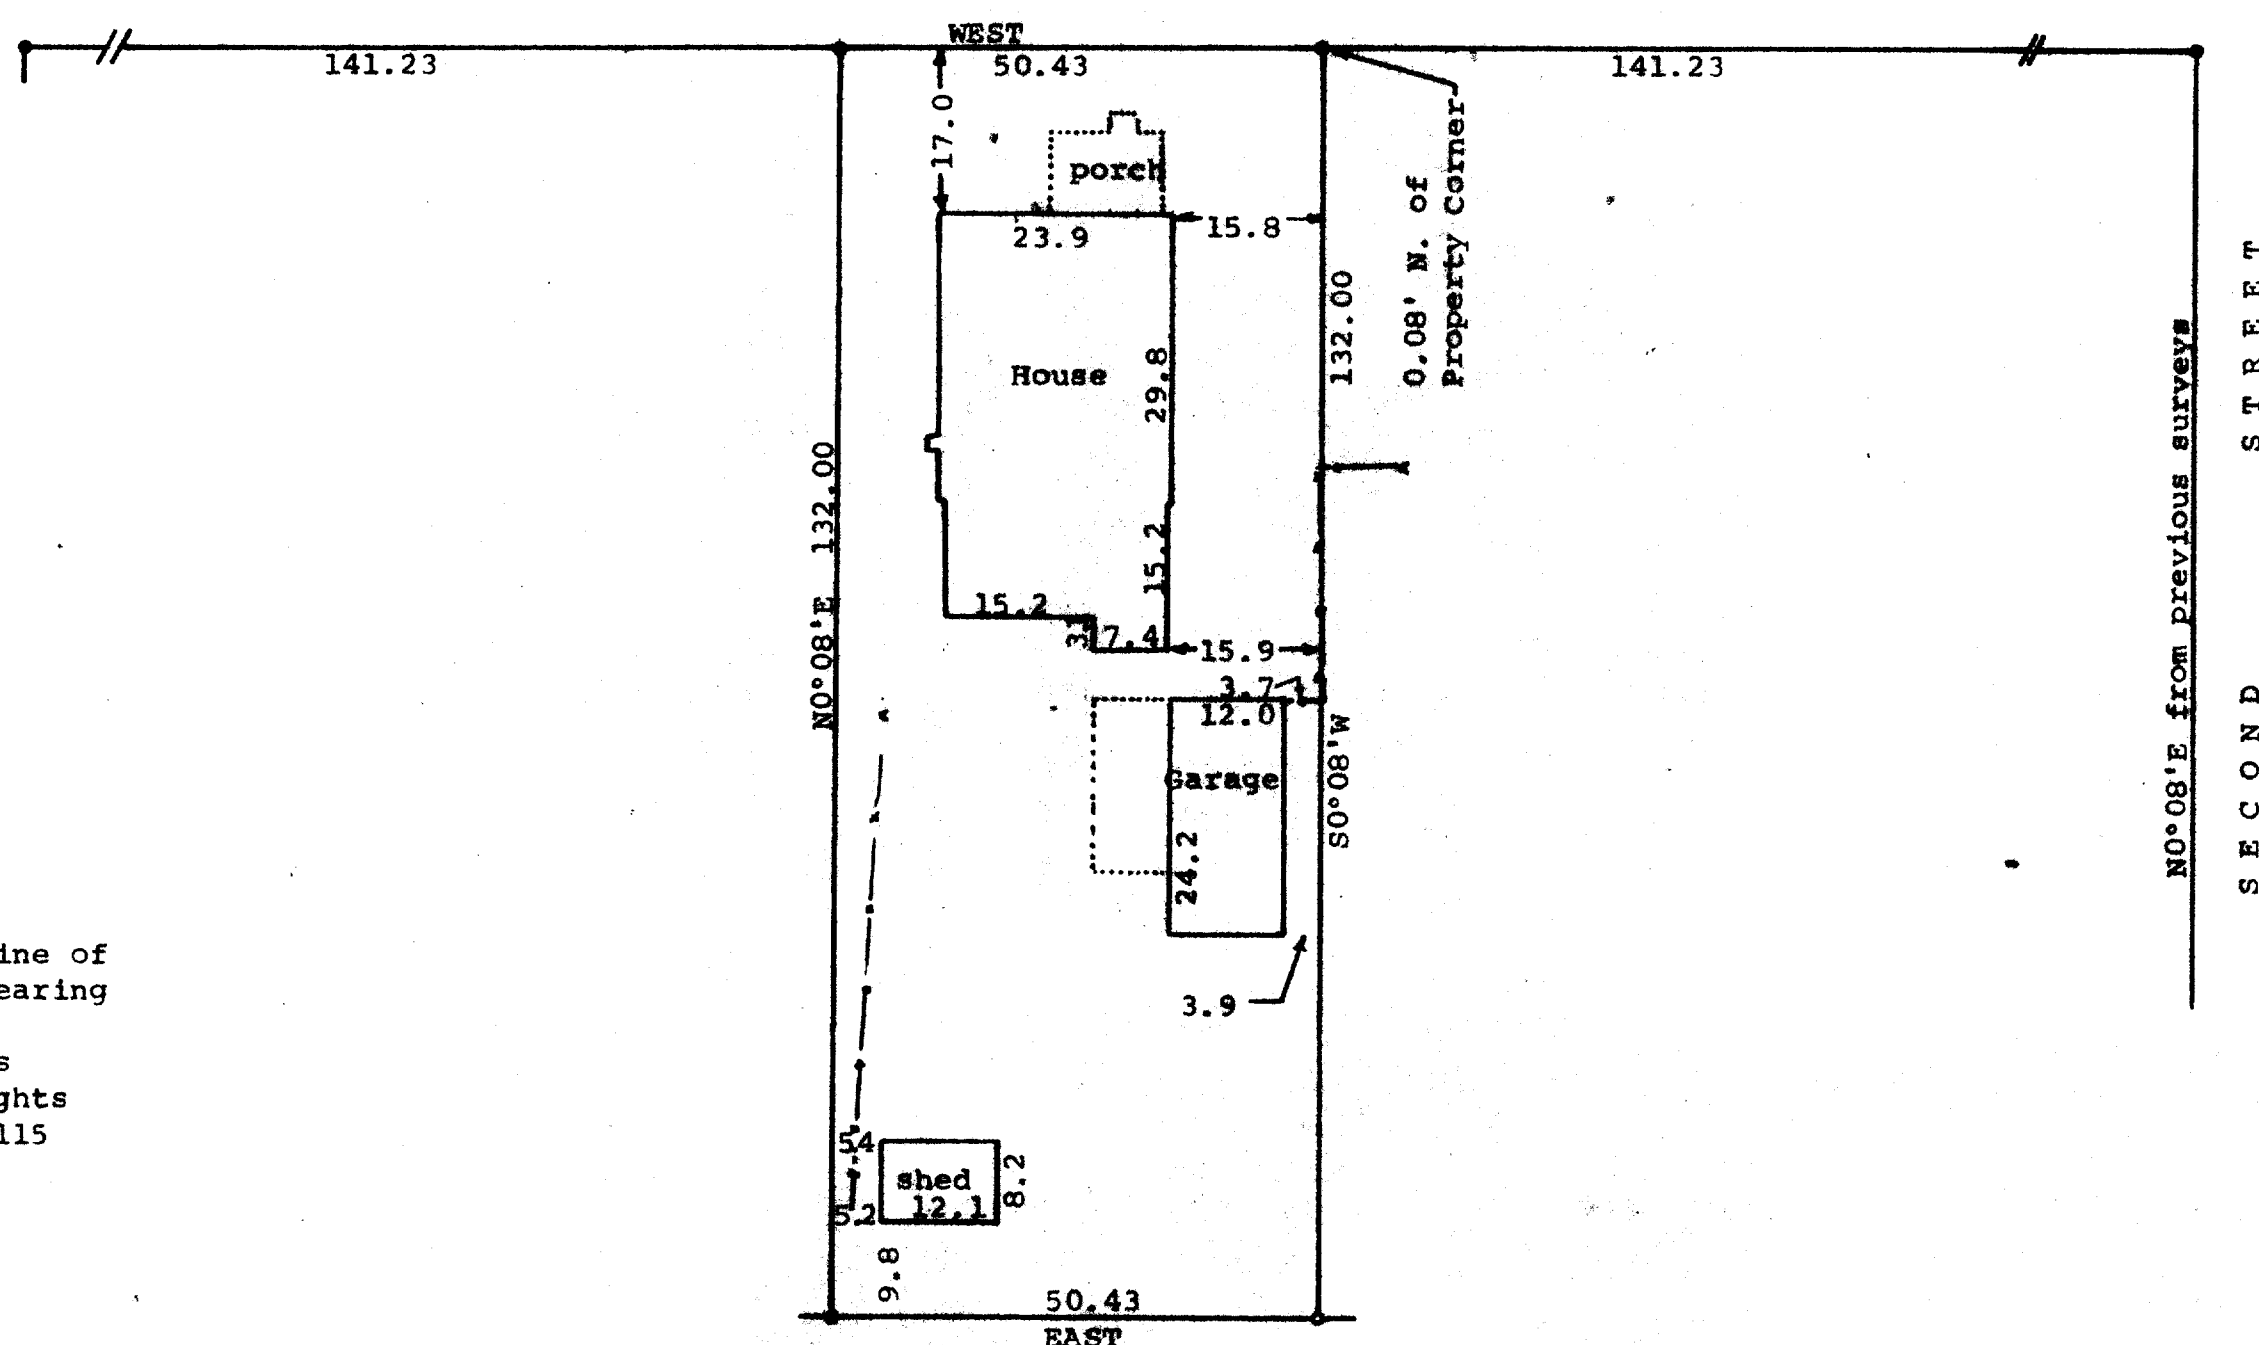

Survey ordered by: Carmin Realtors
537 Laurel Heights
Dehavan, WI 53115

George T. Dunham
George T. Dunham, Surveyor

