


ABELL
SURVEYING & MAPPING
DEHAVAN, WISCONSIN 53115
414-728-6737

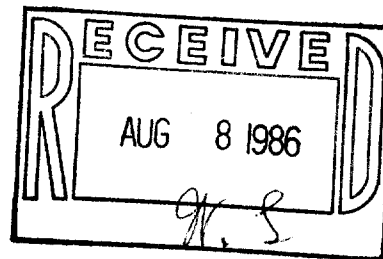

PARISH STREET

5th STREET

(WEST 48') 48.02'

POINT DESCRIBED AS BEING
1' NORTH AND 117' WEST OF
THE NW CORNER OF LOT 5,
BLOCK 2 OF LATHROP'S ADD.
TO THE VILLAGE (NOW CITY)
OF DELAVAN.

NOTE: 10 rods = 165'

PLAT OF SURVEY OF

A PARCEL OF LAND LOCATED IN
THE NORTHEAST 1/4 OF SECTION
18, T2N, R16E, CITY OF
DEHAVAN, WALWORTH COUNTY,
WISCONSIN, AS DESCRIBED IN
VOLUME 255 OF RECORDS ON
PAGE 82 AS DOCUMENT NO.
60439, WALWORTH COUNTY,
WISCONSIN.

ORDERED BY: CENTURY 21 -
SKANDIA REALTY
312 S. 7th STREET
DEHAVAN, WI. 53115

IRON PIPE 0.86' E. OF LINE

(SOUTH 10 rods)

CONCRETE DRIVE

GRAVEL DRIVE

IRON PIPE 0.13' E. OF LINE

(NORTH 10 rods)

EAVES EXTEND 0.6'

GARAGE

GARAGE

SCALE - 1"=20'

LEGEND

- - IRON PIPE FOUND
- - 3/4" IRON ROD SET
- () - RECORDED AS



I, DAVID F. ABELL, DO HEREBY CERTIFY THAT I HAVE SURVEYED THE
PROPERTY HEREON DESCRIBED ACCORDING TO THE OFFICIAL RECORDS,
AND THAT THE PLAT HEREON IS A CORRECT REPRESENTATION OF THE
PROPERTY LINES TO THE BEST OF MY KNOWLEDGE AND BELIEF.

David F. Abell

DAVID F. ABELL
WISCONSIN REGISTERED LAND SURVEYOR, S-1596

DATE *June 8, 1986*

JOB NUMBER - 86006

2-719

XTP-61