
## PLAT OF SURVEY

Z-378-33568

LOT 11 - BLOCK 7 - SPRINGS PARK SUBDIVISION ADDITION NO. 2, located in the Southwest 1/4 of Section 18, Town 2 North, Range 16 East, City of Delavan, Walworth County, Wisconsin.

Located at 316 Spring Drive


Owners: Richard E. and Suzanne M. Johnson

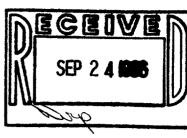

SPRING

DRIVE

(66')

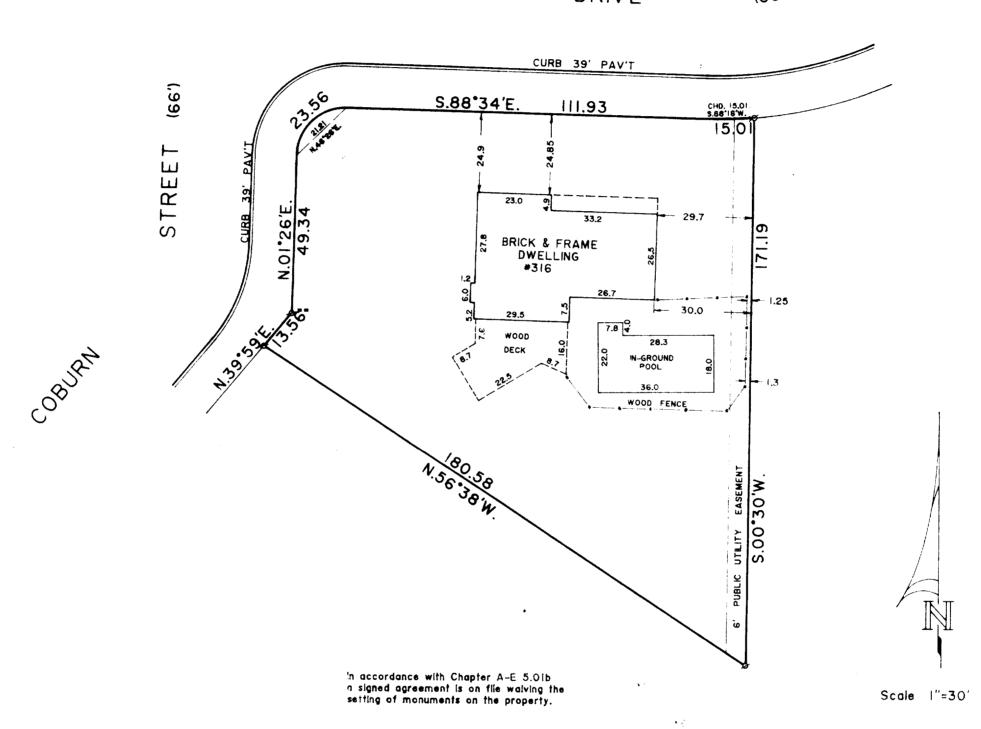

W FOUND IRON PIPE

o SET IRON PIPE

8522 West Lisbon Avenue Milwaukee, Wisconsin 53222

SURVEYED FOR

Security Savings and Loan Assn. 1055 N. Mayfair Rd. Wauwatosa, Wisconsin 53226

## LANDMARK SURVEYING CO.

I. Richard J. Lammi, surveyed the above described property, and the above map is a true representation thereof and shows the size and location of the property, its exterior boundaries, the location and dimensions of all visible structures thereon, fences, apparent easements roadways and visible encroachments.

This survey is made for the exclusive use of the present owners of the property; also those who purchase, mort gage or guarantee the title thereto, within one year from date hereof.

REGISTERED LAND SURVEYOR NO. 5-777 - STATE OF WISCONSIN

PHONE 461-3730

