


PARISH

STREET

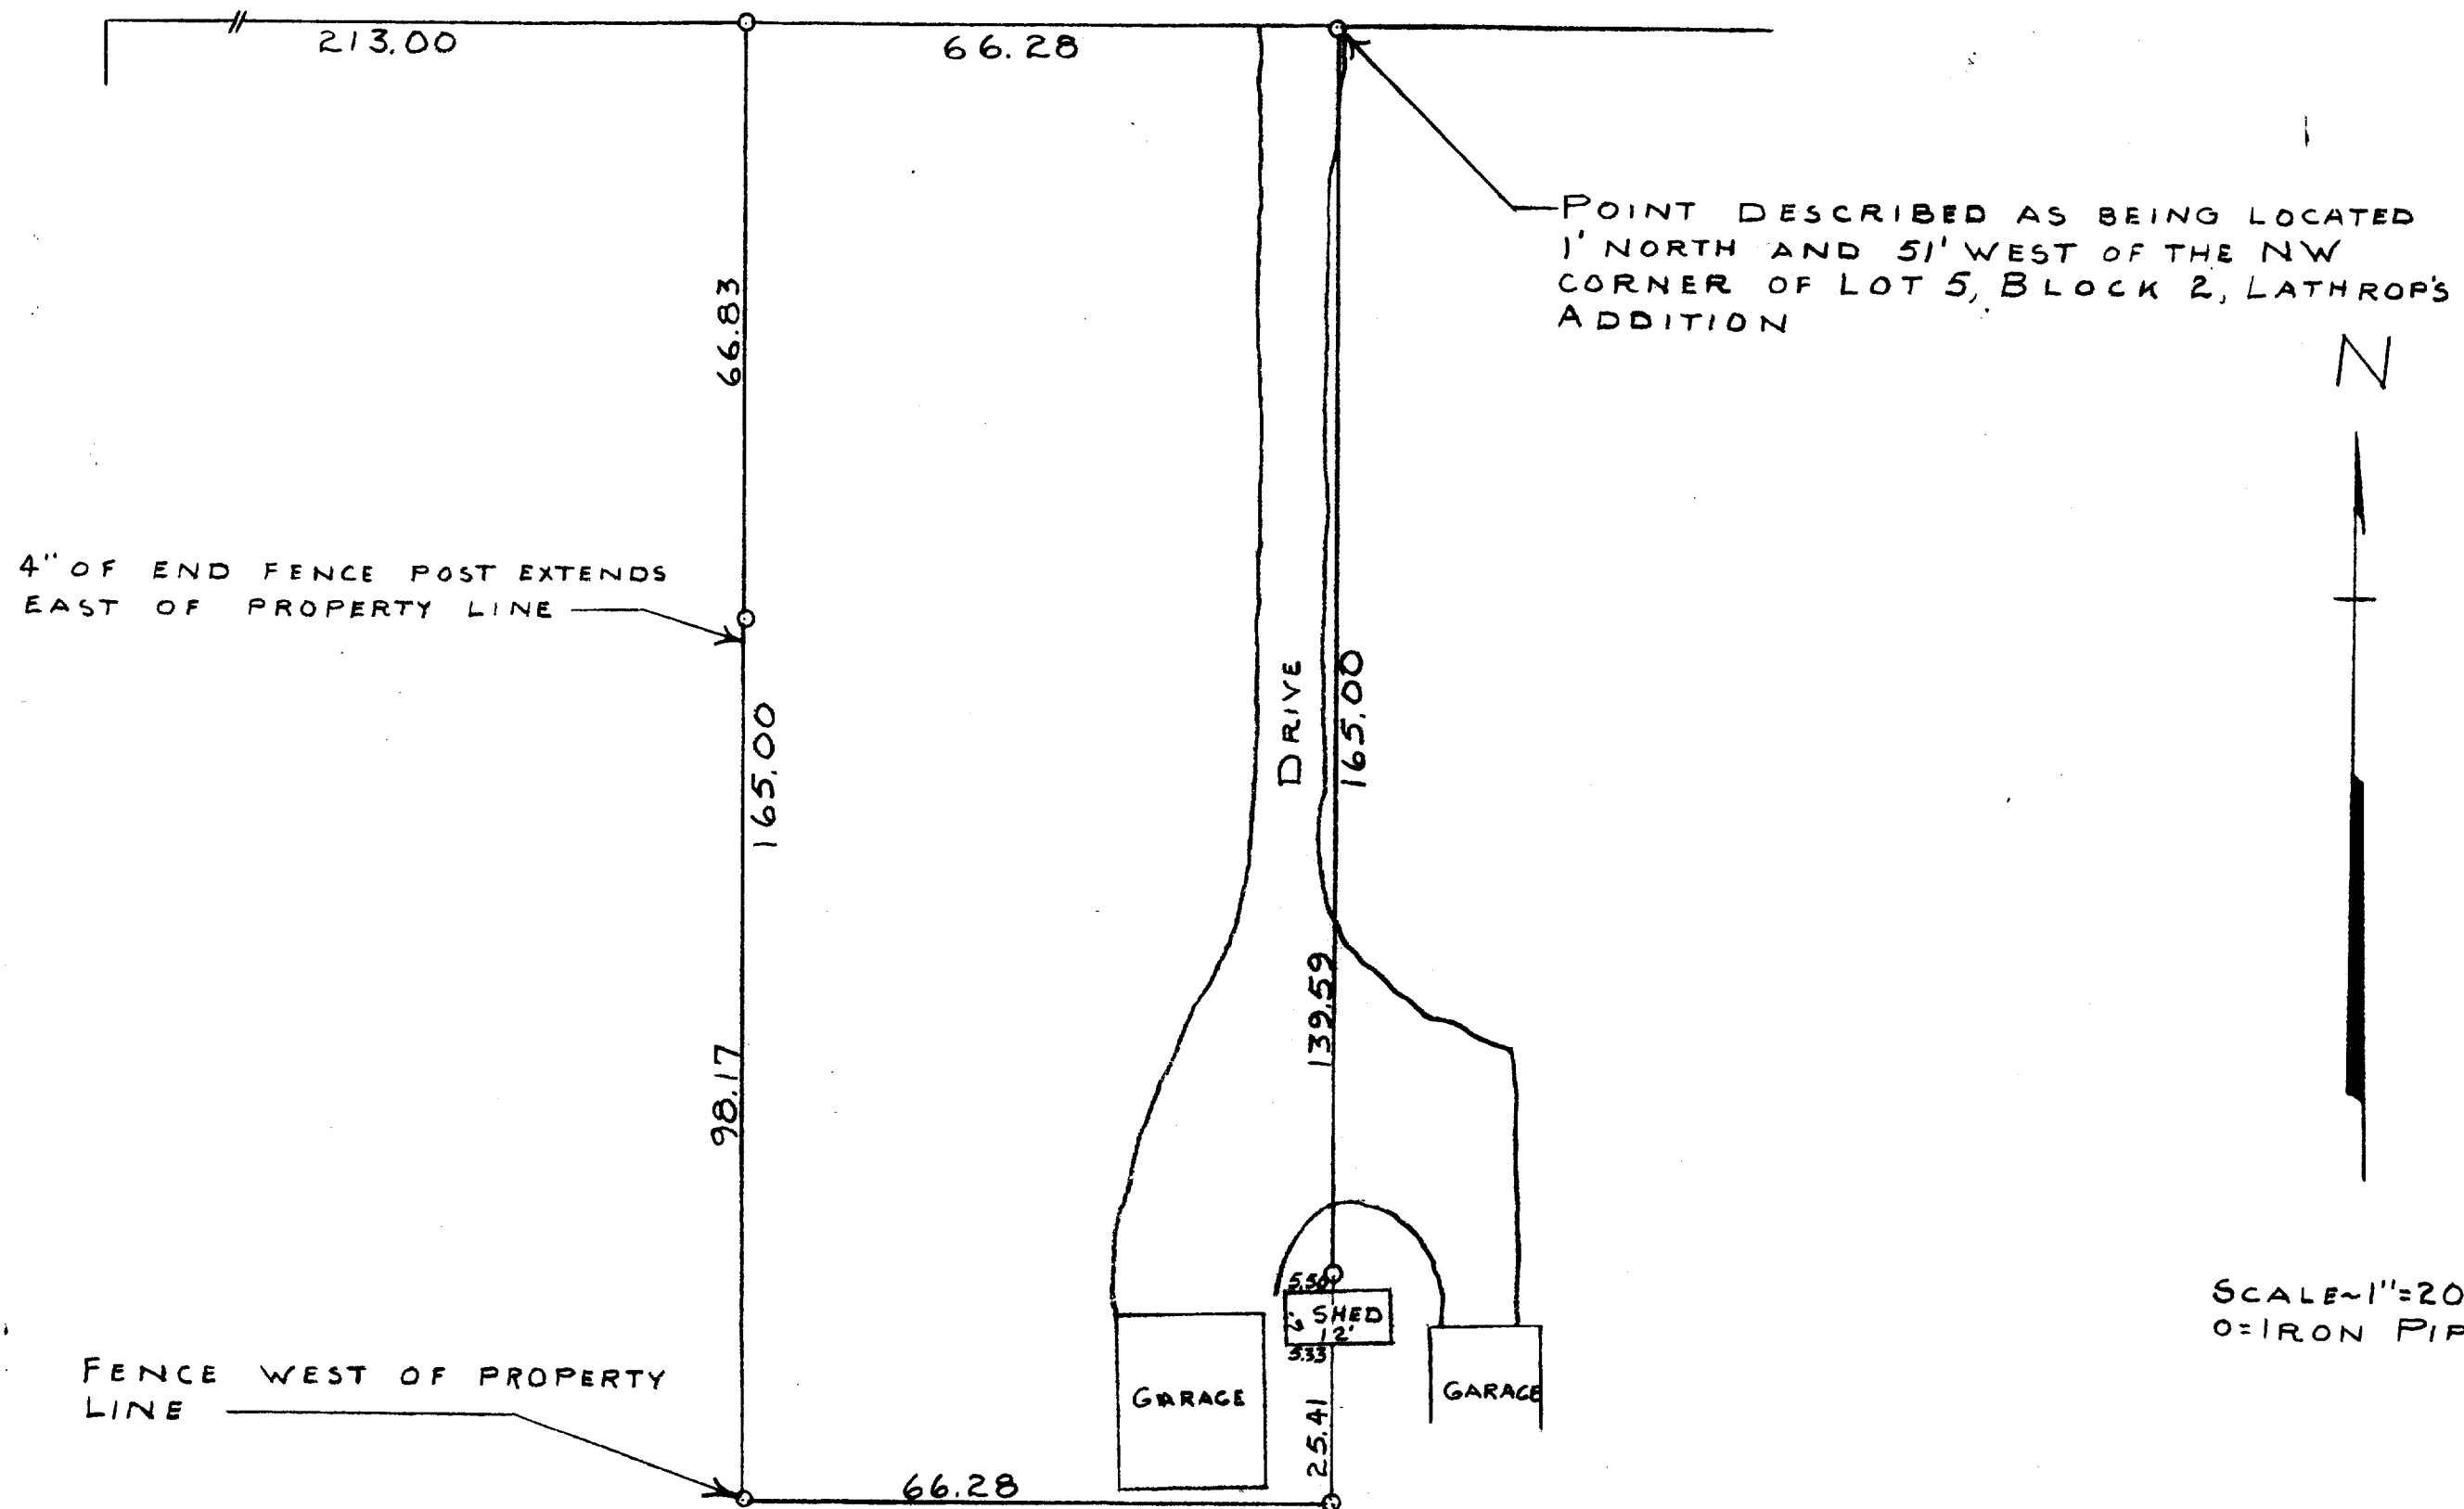

PLAT OF SURVEY OF A PARCEL OF LAND LOCATED IN THE NE 1/4 OF
SECTION 18, T2N R16E, CITY OF DELAVAN, WALWORTH COUNTY,
WISCONSIN
MAY 23, 1957

George T. Dunham
GEORGE T. DUNHAM, SURVEYOR
DELAVAN, WIS