
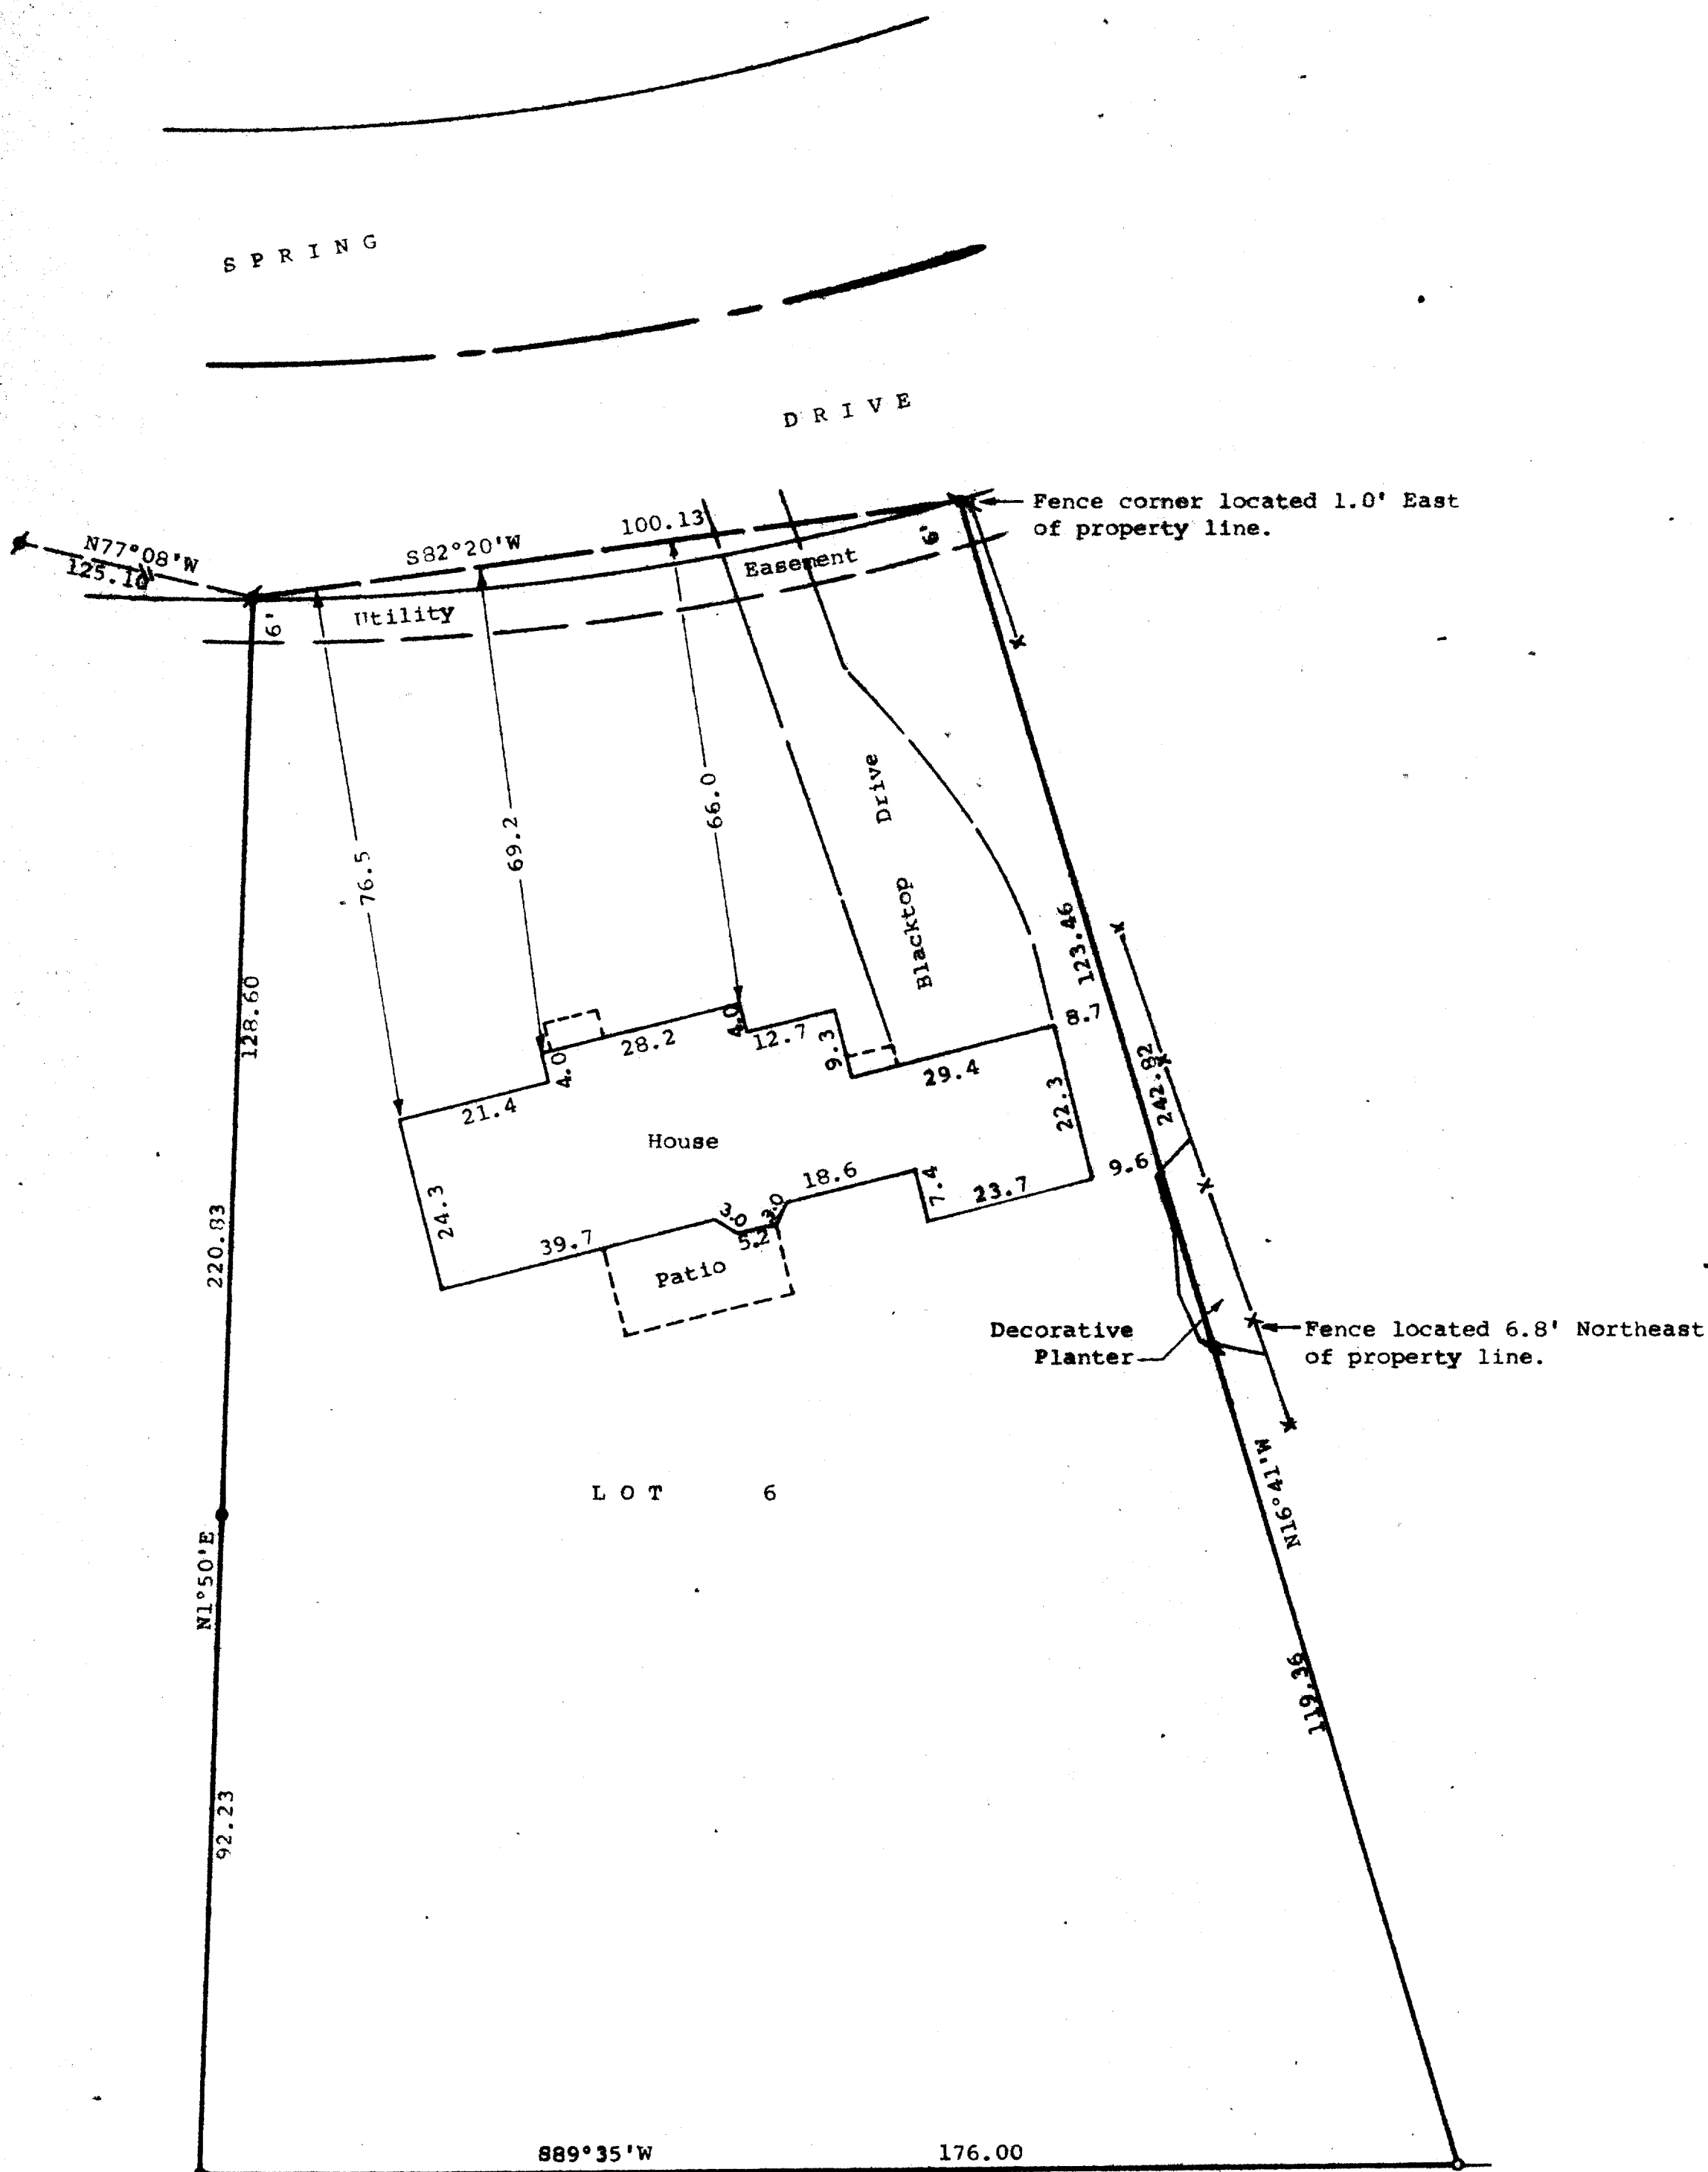


DUNHAM SURVEYING, S.C.
SURVEYING & SUBDIVIDING
DELAVER, WISCONSIN 53115

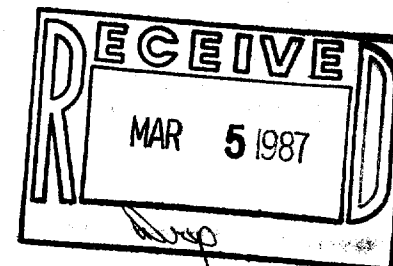

Scale - 1" = 20'
● = 3/4" Dia. Iron Pipe Found
○ = 1" Dia. Iron Pipe Found
○ = 1 1/4" Dia. Iron Pipe Found
x = 1 1/4"x24" Iron Pipe Set
x-x = Fence

Bearings are those of record.
Survey Ordered By:
Skandia Realty
312 S. 7th Street
Delaver, Wisconsin 53115

STATE OF WISCONSIN)
COUNTY OF WALWORTH) SS
I, Richard C. Schulz, Surveyor, certify that I have surveyed
the property described as follows,
Lot 6, Block 7 of Springs Park Subdivision Addition No. 2,
located in the Southwest 1/4 of Section 18, T2N, R16E, City
of Delaver, Walworth County, Wisconsin,
and that the map shown above is a true representation thereof and shows
the size and location of the property, its exterior boundaries, the
location of all visible structures and dimensions of all principal buildings,
thereon, boundary fences, apparent easements, roadways and visible encroachments,
if any, and that I have surveyed the property described hereon according to
the official records, to the best of my knowledge and belief.
August 20, 1986.

Richard C. Schulz
Richard C. Schulz, Surveyor

