


FARRIS, HANSEN & ASSOCIATES, INC.  
7 RIDGEWAY COURT, ELKHORN, WI  
414-723-2098


PLAT OF SURVEY OF

LOT 7 OF BLOCK 14 OF ALLYNHURST ADDITION NO. 3, CITY OF DELAVAN, WALWORTH COUNTY,  
WISCONSIN

WORK ORDERED BY: SOUTHEASTERN WISCONSIN HOUSING C/O BOB STEIN

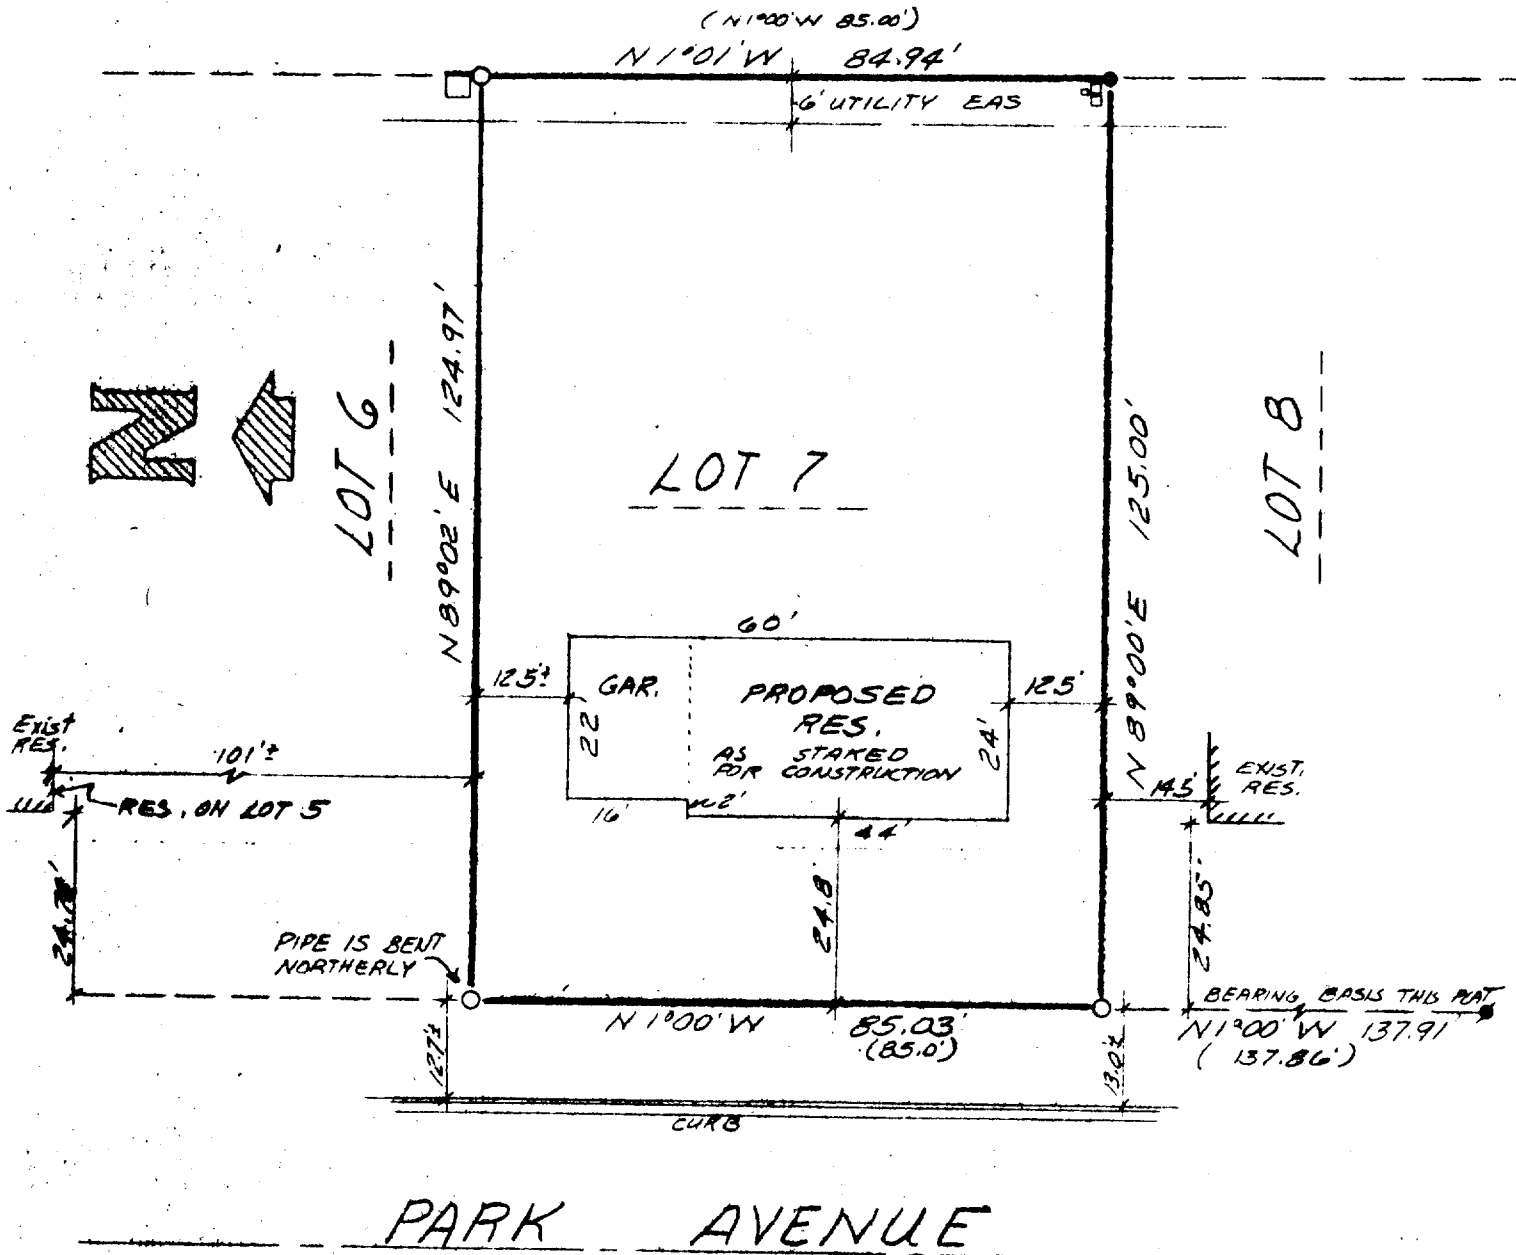

PARK AVENUE

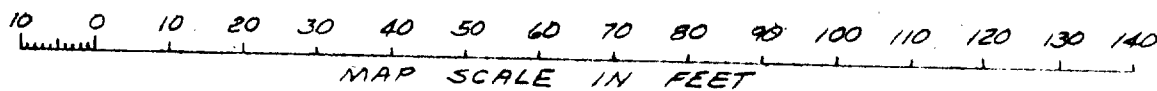

○ = FOUND IRON PIPE STAKE   ● = SET RE-BAR STAKE   \* = FOUND RE-BAR  
(xxx) = ORIGINAL PLAT DIMENSION

I hereby certify that this plat of survey is a true and accurate representation of the lot lines and proposed building location to the best of my knowledge and belief.

*Robert A. Farris*  
Robert A. Farris, R.L.S.

Dated this 19th day of February, 1987



PROJ. # 2723