


DUNHAM SURVEYING, S.C.
SURVEYING & SUBDIVIDING
DELAVER, WISCONSIN 53115



Scale - 1" = 20'
 ● = 1/2" Dia. Iron Pipe Found
 ● = Concrete Monument Found
 — = Fence
 ● = 3/4" X 24" Iron Pipe Set
 Bearings are referenced to the North line of McDowell Street, assumed bearing of East.

Survey Ordered By:
 Century 21
 Skandia Realty
 312 S. 7th Street
 Delavan, WI 53115

Fifth Street

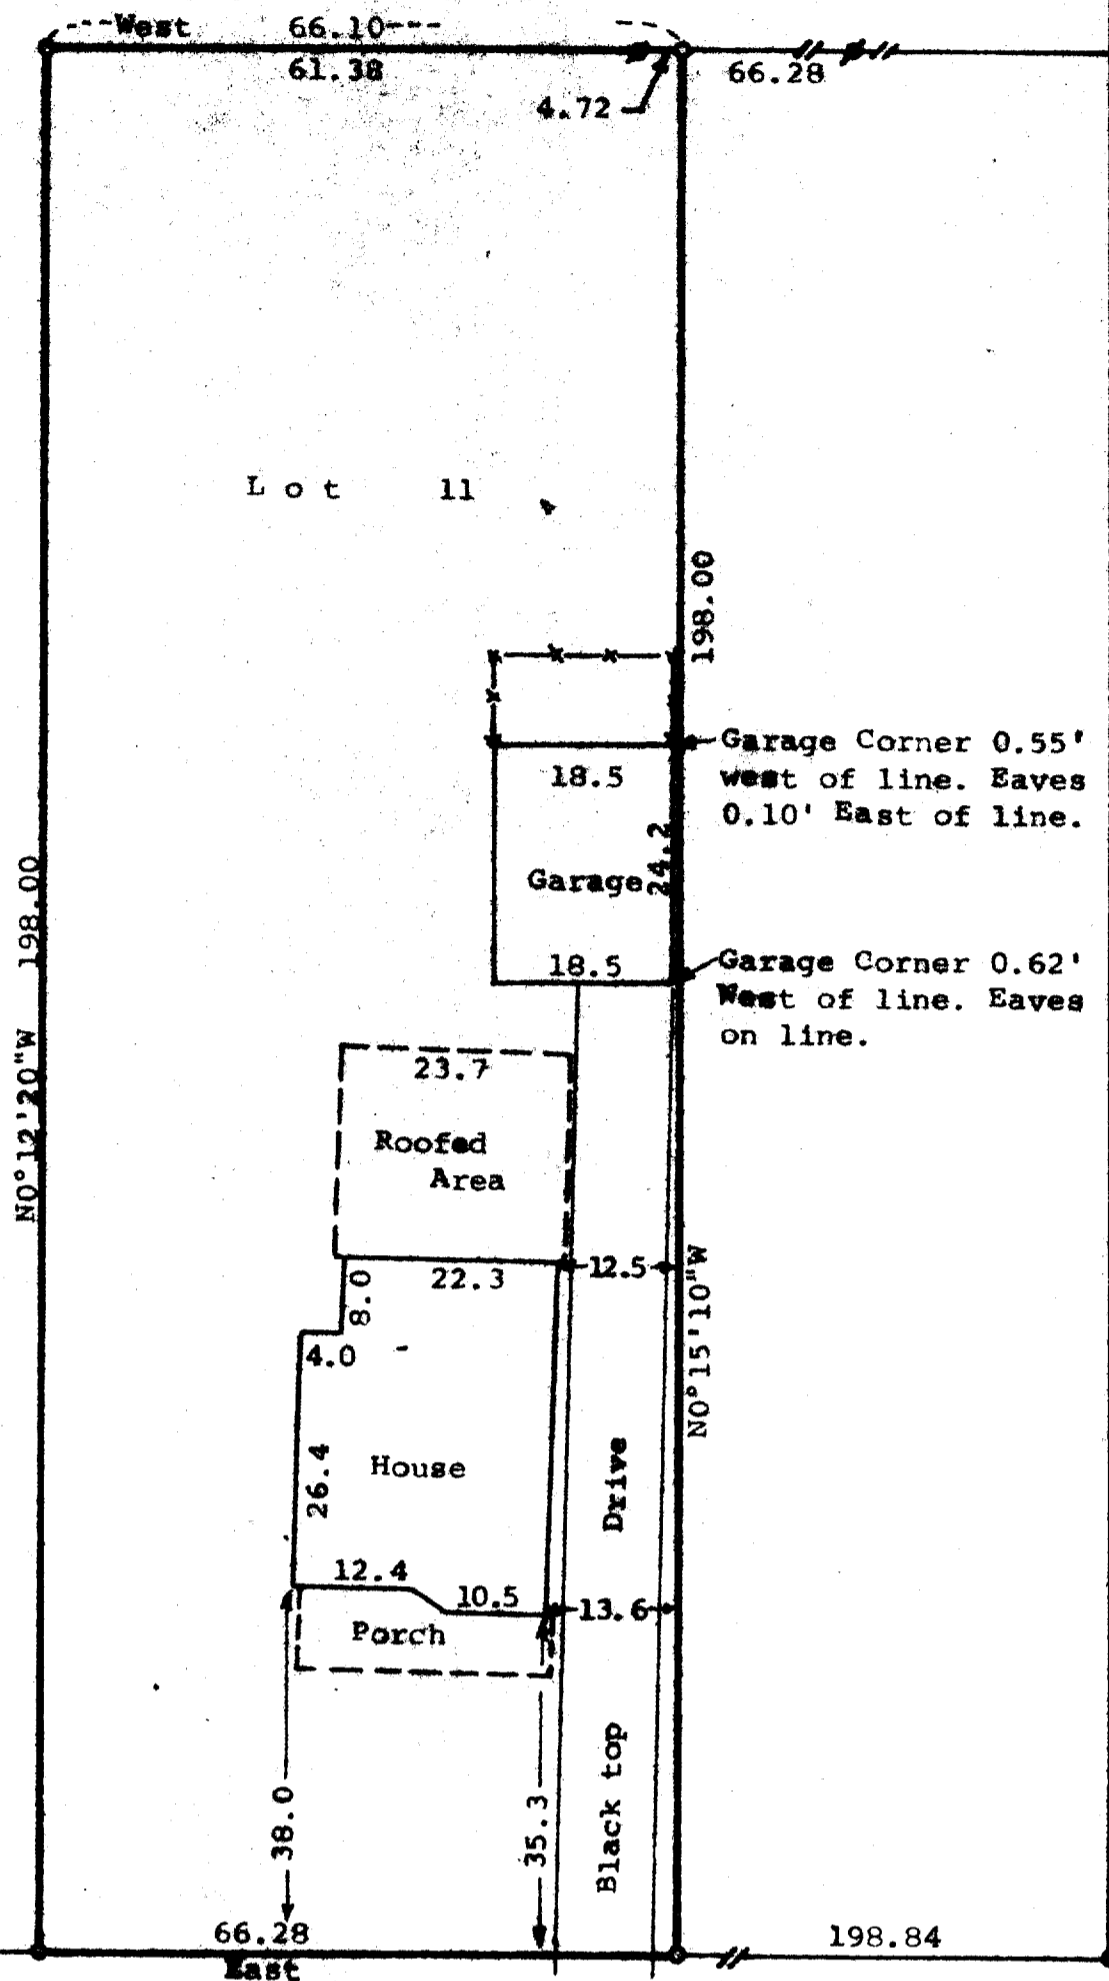

SEVENTH STREET

MCDOWELL

STREET

STATE OF WISCONSIN)
 COUNTY OF WALWORTH) SS

I, Richard C. Schulz, Surveyor, certify that I have surveyed the property described as follows:
 Lot 11 of Bells Subdivision, located in the City of Delavan, Walworth County, Wisconsin,

and that the map shown hereon is a correct representation thereof and shows the size and location of the property, its exterior boundaries, the location of all visible structures and dimensions of all principal buildings thereon, boundary fences, apparent easements, roadways and visible encroachments, if any, and that I have surveyed the property hereon described according to the official records, to the best of my knowledge and belief.
 June 23, 1987.

Richard C. Schulz
 Richard C. Schulz, Surveyor

