
DUNHAM SURVEYING, S. C. SUNGEYING & SURDIVIDING DELAYAN, WISCONSN 53115

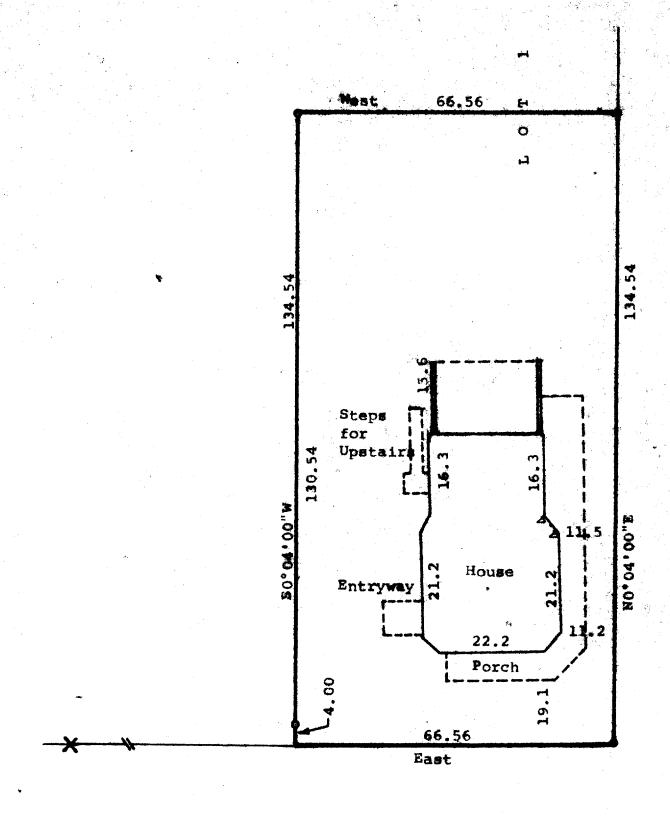

Scale - 1" = 20"

• = Concrete Monument Found

• = 1" Dia. Iron Pipe Found

X = Cross Cut in Concrete

Found

Bearings used are those of previous surveys.

Survey Ordered Byr
Johannesen-Farrar Inc.
110 S 3rd Street
Delavan, Wis. 53115

McDowell

Street

STATE OF WISCONSIN)
COUNTY OF WALWORTH) 88


I, Richard C. Schulz, Surveyor, certify that I have surveyed the property described as follows,

The South 134.54 feet of Lot 1, Block 3 of the Original Plat of the Village, (now City), of Delavan, Walworth County, Wisconsin,

and that the map shown above is a correct representation thereof and shows the size and location of the property, its exterior boundaries, the location of all visible structures and dimensions of all principal buildings thereon, boundary fences, apparent essements, roadways and visible encroachments, if any and that I have surveyed the property hereon described, according to the official records, to the best of my knowledge and belief.

June 30, 1987.

WECEINE

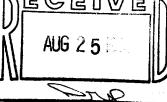

Richard C. Schulz, Surveyor

