
KOLB LAND CONSULTING, INC.

LAND SURVEYING . SUBDIVIDING . LAND PLANNING

929 WILLIAMS STREET

LAKE GENEVA, WISCONSIN 53147

414-248-3697

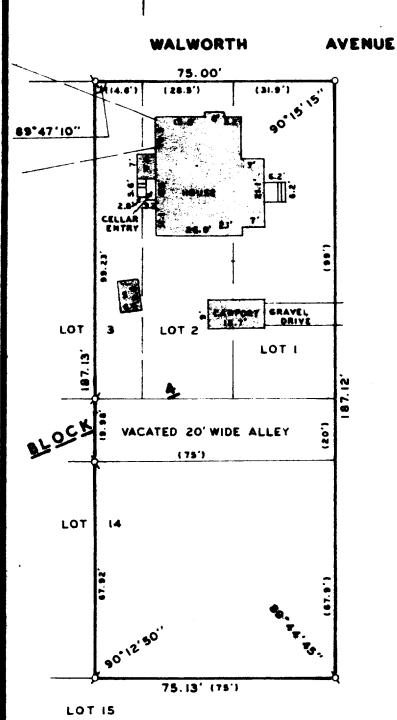



SCALE: 1" = 30'

LEGEND

p - IRON PIPE FOUND

O - IRON ROD SET

S - SHED

P - PORCH

() - AS RECORDED

-- OVERHEAD UTILITY LINE

ORDERED BY: STONEWALL REALTY
201 W. WASHINGTON
DELAVAN, WI. 53115

PLAT OF SURVEY OF

LOT 1 & 2 AND THE EAST 14.6' OF LOT 3 AND THE EAST 75' OF LOT 4, AND THE EAST 75' OF A VACATED 20' WIDE ALLEY, BLOCK 4 OF F.K. PHOENIX SUBDIVISION, CITY OF DELAVAN, WALWORTH COUNTY, WISCONSIN.



I HEREBY CERTIFY THAT I HAVE SURVEYED THE ABOVE DESCRIBED PROPERTY AND THAT THE ABOVE MAP IS A TRUE REPRESENTATION THEREOF AND SHOWS THE AND LOCATION OF THE PROPERTY, ITS EXTERIOR BOUNDARIES, THE LOCATION OF ALL VISIBLE STRUCTURES AND DIMENSIONS OF ALL PRINCIPAL BUILDINGS THEREON, BOUNDARY FENCES, APPARENT EASEMENTS, ROADWAYS AND VISIBLE ENCROACHMENTS, IF ANY, TO THE BEST OF MY KNOWLEDGE AND BELIFF.

THIS SURVEY IS MADE FOR THE USE OF THE PRESENT OWNERS OF THE PROPERTY AND ALSO THOSE WHO PURCHASE, MORTGAGE OR GUARANTEE THE TITLE THERETO WITHIN ONE (1) YEAR FROM DATE HEREOF.

SURVEY NOT VALID UNLESS SURVEYOR'S SIGNATURE IS IN RED.

HAROLD H. KOLB	
WISCONSIN REGISTERED LAND SURVEYOR, S-DATE AUGUST 31, 1987	187
REVISED	
REVISED	
	` `&\79?

XPFR-13