



RECEIVED  
NOV 25 1987

ABELL  
SURVEYING & MAPPING  
DELAVAN, WISCONSIN 53115  
414-728-6737

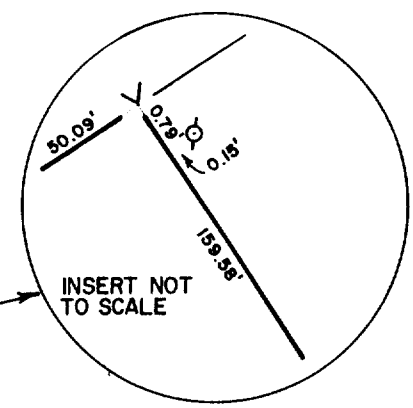

ORDERED BY: CENTURY 21-SKANDIA  
REALTY  
312 S. 7th ST.  
DELAVAN, WI. 53115

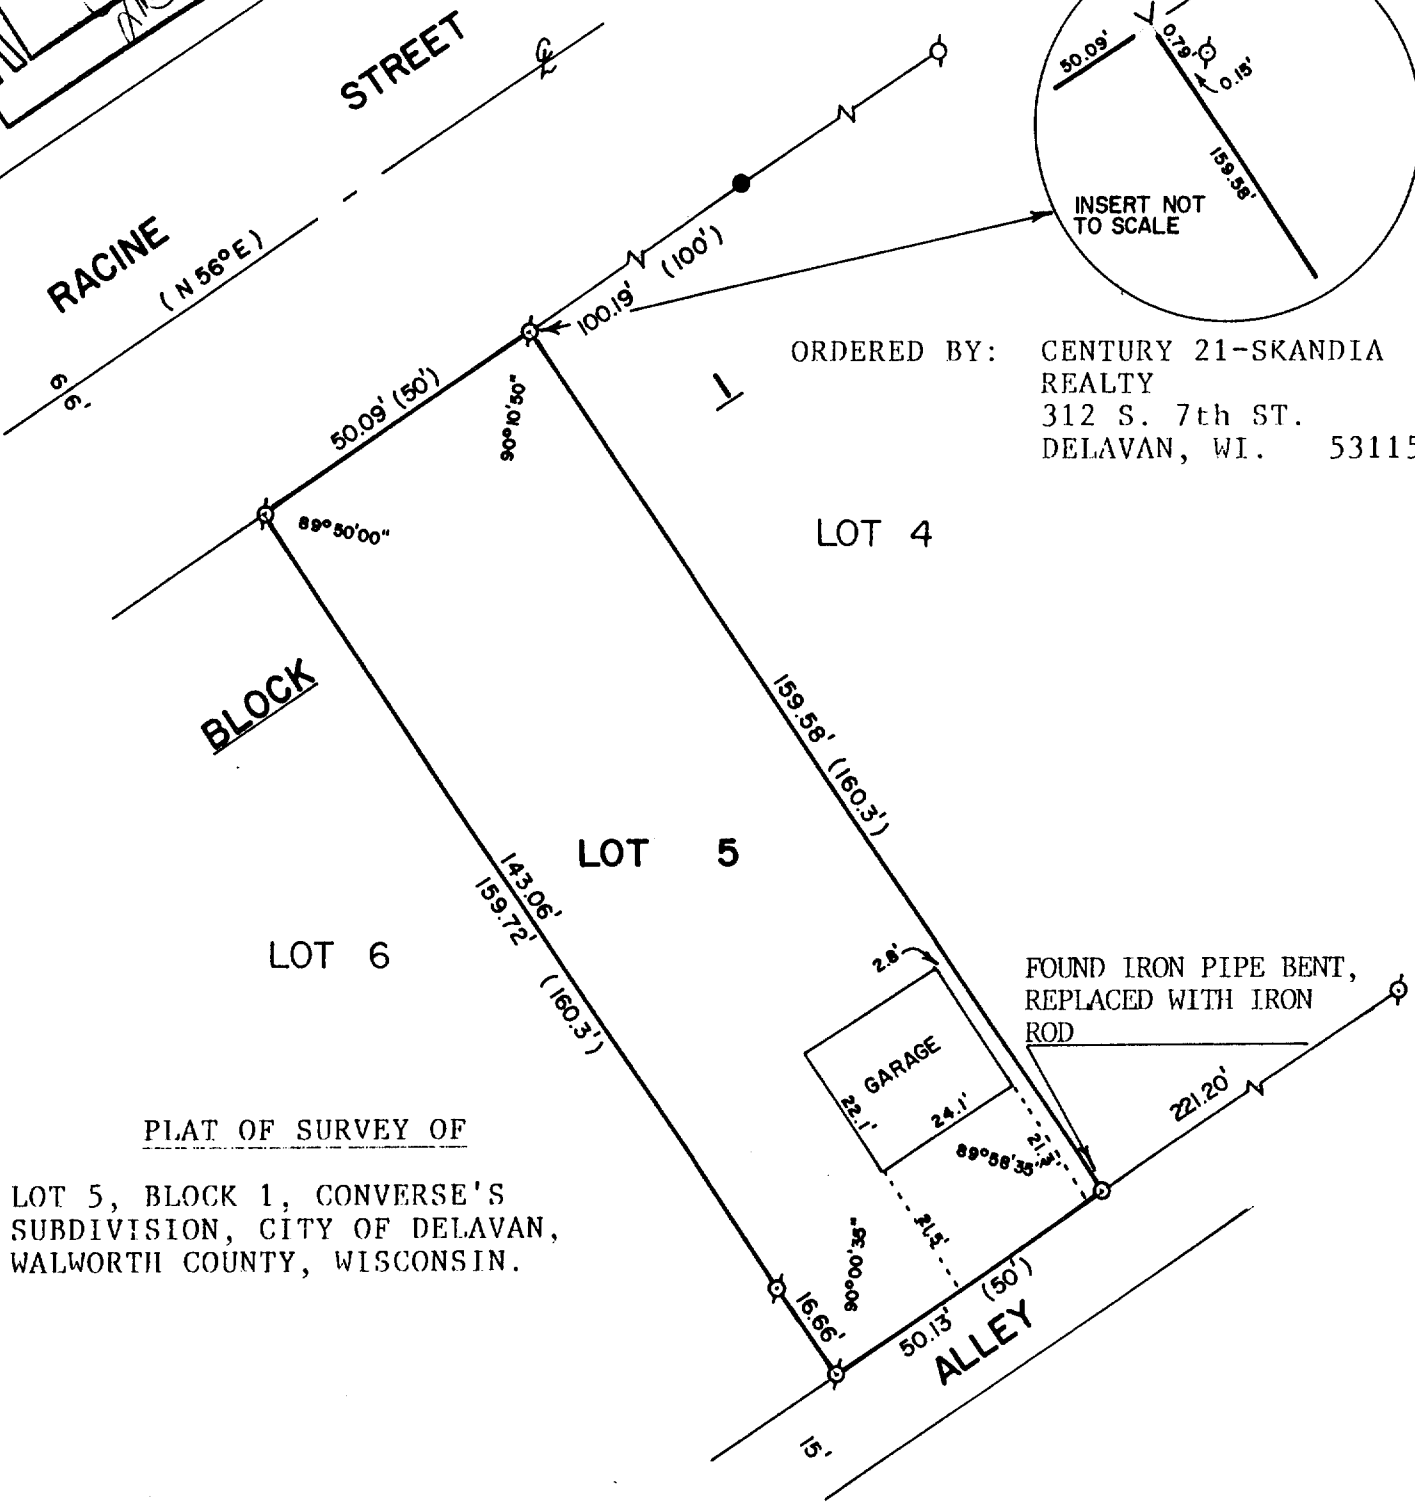

PLAT OF SURVEY OF  
LOT 5, BLOCK 1, CONVERSE'S  
SUBDIVISION, CITY OF DELAVAN,  
WALWORTH COUNTY, WISCONSIN.



SCALE - 1"=30'

LEGEND

- ⊗ - IRON PIPE FOUND
- - 3/4" DIA. IRON ROD SET
- - IRON ROD FOUND
- ( ) - RECORDED AS
- ✓ - CUT V IN CONCRETE SIDEWALK

I, DAVID F. ABELL, DO HEREBY CERTIFY  
THAT I HAVE SURVEYED THE PROPERTY  
HEREON DESCRIBED ACCORDING TO THE  
OFFICIAL RECORDS AND THAT THE PLAT  
HEREON IS A CORRECT REPRESENTATION  
OF THE PROPERTY LINES TO THE BEST OF  
MY KNOWLEDGE AND BELIEF.

*David F. Abell*  
DAVID F. ABELL  
WISCONSIN REGISTERED LAND SURVEYOR, S-1596

*October 26, 1987*  
DATE JOB NUMBER - 87163  
NOTE: THIS IS NOT A CERTIFIED COPY UNLESS SEALED.