


EAVES ON HOUSE EXTEND NORTH OF LOT
LINE BETWEEN 1.0' AND 1.2'



ORDERED BY: CENTURY 21 - SKANDIA REALTY
312 S. 7th STREET
DELAVER, WISCONSIN 53115

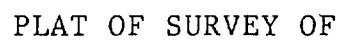

LEGEND

♂ - IRON PIPE FOUND
● - IRON ROD SET

David F. Abell

June 9, 1988

DATE June 1, 1966 JOB NUMBER - 88097

NOTE: THIS IS NOT A CERTIFIED COPY UNLESS SEALED. 2-85