



ABELL
SURVEYING & MAPPING
DELAVER, WISCONSIN 53115
414-728-6737

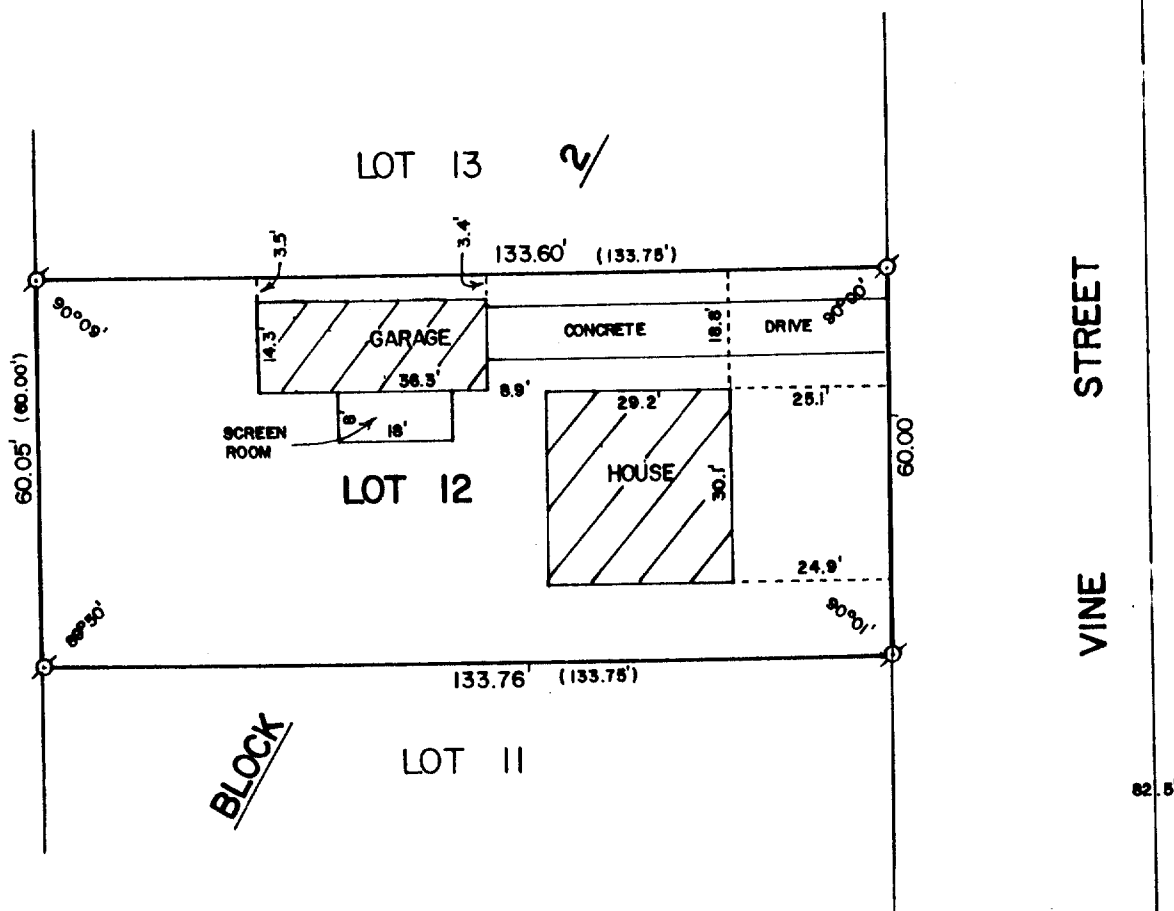

PLAT OF SURVEY OF

LOT 12, BLOCK 2 OF SUNSET VIEW SUBDIVISION, LOCATED
IN THE CITY OF DELAVER, WALWORTH COUNTY, WISCONSIN.

ORDERED BY: CENTURY 21 - SKANDIA REALTY
312 S. 7th STREET
DELAVER, WI. 53115

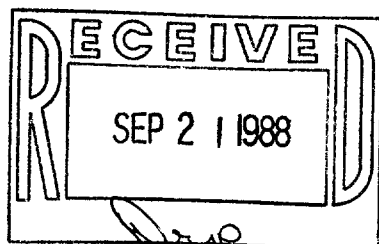

SCALE - 1"=30'

LEGEND

- ⌀ - IRON PIPE FOUND
() - AS SHOWN ON EXISTING
SURVEY RECORDS

I, DAVID F. ABELL, DO HEREBY CERTIFY
THAT I HAVE SURVEYED THE PROPERTY
HEREON DESCRIBED ACCORDING TO THE
OFFICIAL RECORDS AND THAT THE PLAT
HEREON IS A CORRECT REPRESENTATION
OF THE PROPERTY LINES TO THE BEST OF
MY KNOWLEDGE AND BELIEF.

David F. Abell

DAVID F. ABELL
WISCONSIN REGISTERED LAND SURVEYOR, S-1596

August 5, 1988

DATE JOB NUMBER - 88176

NOTE: THIS IS NOT A CERTIFIED COPY UNLESS SEALED. 2-857