
DUNHAM SURVEYING, S.C. SUMPETIME & SUMPRIMING DELAYAN, WISCONSIN 53115

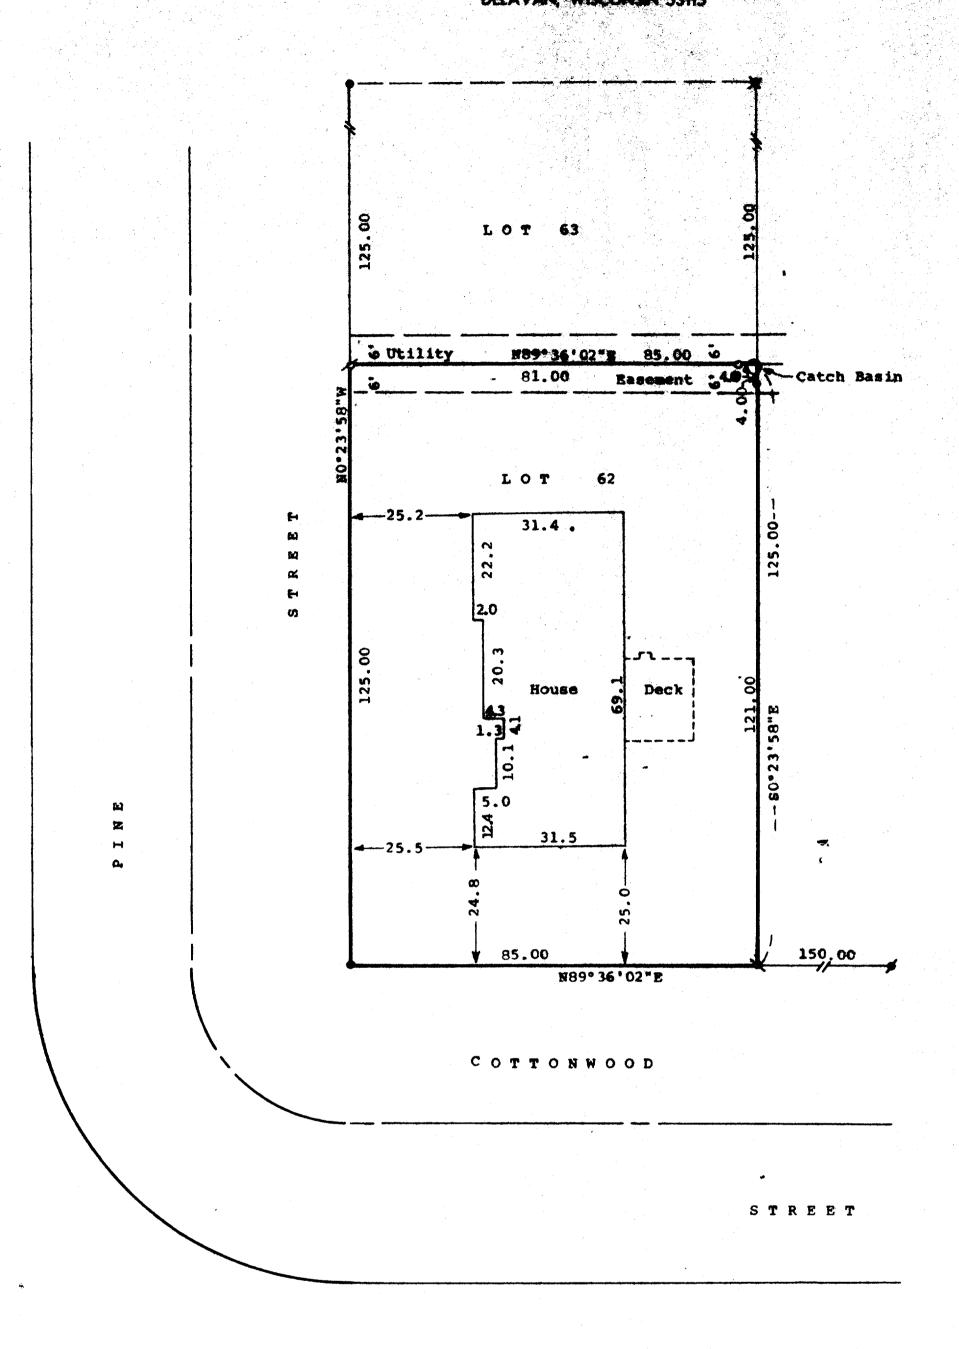

Scale - 1" = 20'• =1 3/16" Dia. Iron Bar Found m = 5/8" Dia. Iron Bar Found & Reset # = 3/4" Dia. Iron Pipe Found o = 3/4"x24" Iron Pipe Set X = 1" Iron Pipe Found Bearings are those of record.

Survey Ordered By: Realty World Carmin Realtors 811 E. Geneva Street Delavan, WI 53115

STATE OF WISCONSIN) SS COUNTY OF WALMORTH)

I, George T. Dunham, Surveyor, certify that I have surveyed the property described as follows,

Lot 62 of Turtle Creek, a subdivision located in the Southeast & of Section 13, T2W, RISE, City of Delavan, Walworth County, Wisconsin and that the wap shown hereon is a correct representation thereof and shows the size and location of the property, its exterior boundaries, the location of all visible structures and dimensions of all principal buildings thereon, boundary fences, apparent easements, roudways and visible encroachments, if any, and that I have surveyed the property hereon described according to the official remotes, to the best of my knowledge and belief.

