


N



George T. Dunham
George T. Dunham, Surveyor

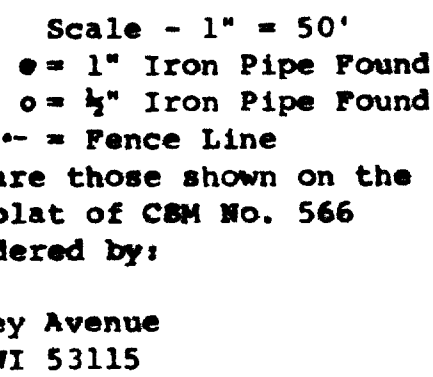