
COAT OF SHRYEY T-65697 . Effective date: August 8, 1988 at 8:00 a.m. 43,000.00 Bearings referenced Ronald Siedelmann and Camille T. Siedelmann to the West B ALTA Loan Policy Proposed Insured line of Second Street assumed as NORTH J. David Carroll, as Personal Representative of the Estate of Marie A. Dooley, deceased $% \left\{ 1,2,\ldots,4\right\}$ 3CALE: 1" = 30!Parcel I: The South 6 feet of the North 32.25 feet of Lot 4, in Block 24 in the City of Delavan. LEGEND Parcel II: The South 44 feet of Lot number 4 in Block number 24 in the original plat of the Yillage (now City) of Delawan, as recorded in the office of the Register of Deeds for said Walworth County, Wisconsin. Found iron pipe Tax Key No. XOP-248 (Note: 1987 net tax is \$1,068.66) Found chiseled cross Recorded dimension ORDERED BY: One Brandner SURVEYED BY: Skandia Realty, Inc. Jensen Surveying & Mapping S.C. 312 8. 7th St. 45 S. Wisconsin St. P.O. Box 322 Delavan. WI 53115 Elkhorn, Wisconsin. 53121 (414) 723-3434 Mapping Date: August 23, 1988 0 N S m 0 OND 5 89° 42' W 166.30 N PARCEL I 0

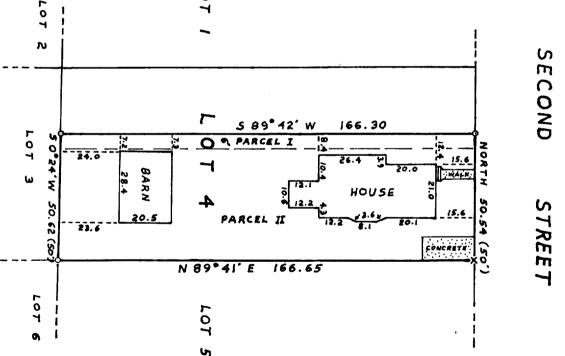

I, Thomas P.A. Jensen, Wisconsin Registered Land Surveyor, do hereby certify that this survey was performed by me, or under my direction, in full compliance with the owner's/agent's instructions and Chapter A-E 5 of the Wisconsin Administrative Code "Minimum Standards For Property Surveys"; and that this map is

Thomas P.A. Jensen R.L.S-1084 Jensen Surveying & Mapping S.C. Note: This survey plat is not certified unless signed and sealed in red ink.

Copyright ② 1988 by Jensen Surveying & Mapping S.C.

All rights reserved. No part of this survey plat may be reproduced or transmitted in any form by any means - graphic, electronic, or mechanical, including photocopying, tracing, or information storage and retrieval systems - without paraission in writing from Thomas P.A. Jensen, Jessen Surveying & Mapping S.C.

J-886

1988.088

