


# FARRIS, HANSEN & ASSOCIATES, INC.

7 RIDGEWAY COURT, P.O. BOX 437, ELKHORN, WISCONSIN

TEL. 414-723-2098



PLAT OF SURVEY LOT 14 & OUTLOT 2, BLOCK 14 OF ALLYNHURST ADDITION NO. 4  
CITY OF DELAVAN, WALWORTH COUNTY, WISCONSIN

WORK ORDERED BY: CITIZENS BANK OF DELAVAN  
BLDG LOC. ORD. BY BRELEUTHIN

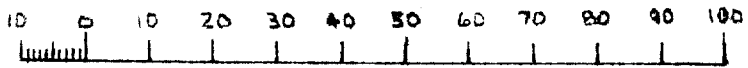

## MAP LEGEND

- = IRON PIPE STAKE FOUND
- = IRON PIPE STAKE SET
- = IRON ROD STAKE FOUND
- = IRON ROD STAKE SET
- = CONCRETE MONUMENT FOUND
- (XXXX) = RECORD DIMENSION
- = UTILITY BOX, □ = TRANSFORMER

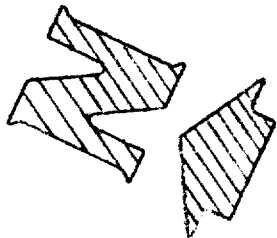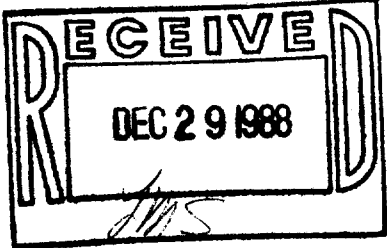

CHORDS  
LOT 14:

N 32° 28' E 80.25' MEAS.  
(N 32° 29' 13" E 79.95' REC.)

OUTLOT 2:

N 37° 44' E 38.27' MEAS.  
(N 37° 42' 53" E 38.05' REC.)



I hereby certify that the above described property has been surveyed under my direction and that the above map is a true representation thereof and shows the size and location of the property, its exterior boundaries, the location of all visible structures and dimensions of all principal buildings thereon, boundary fences, apparent easements, roadways and visible encroachments, if any. This survey is made for the use of the present owners of the property, and also those who purchase, mortgage, or guarantee the title thereto within one year from the date hereof.

XA 54-8, XA 54-9

DATED: MARCH 19, 1988

REVISED 12/24/88

*Robert A. Farris*

TO SHOW NEW RESIDENCE ON THIS LOT.

2-889

PROJECT 2981 B14.L14.0L2

