
ABELL SURVEYING & MAPPING DELAVAN, WISCONSIN 53115 414-728-6737

COTTONWOOD

STREET

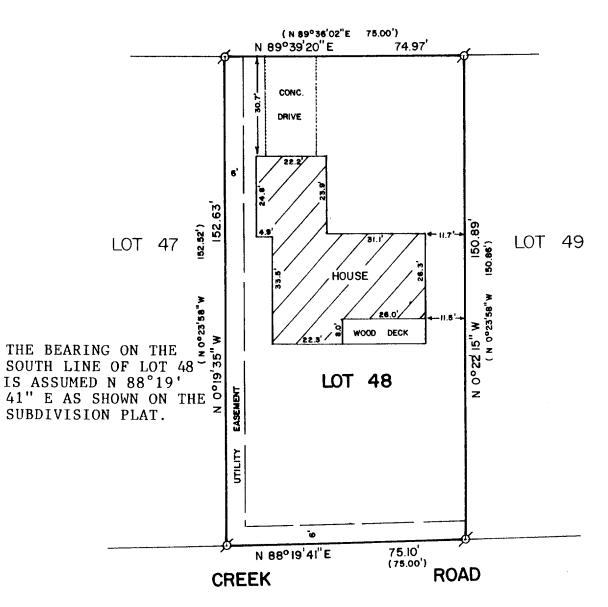

PLAT OF SURVEY OF

LOT 48 OF TURTLE CREEK SUBDIVISION, LOCATED IN THE CITY OF DELAVAN, WALWORTH COUNTY, WISCONSIN.

1/AN | 8 1990

NOTE:

SCALE - 1''=30'

LEGEND Ø - IRON PIPE FOUND ()- RECORDED AS

ORDERED BY: JAMES M. HART

1130 COTTONWOOD ST. DELAVAN, WI. 53115

I, DAVID F. ABELL, DO HEREBY CERTIFY THAT I HAVE SURVEYED THE PROPERTY HEREON DESCRIBED ACCORDING TO THE OFFICIAL RECORDS AND THAT THE PLAT HEREON IS A CORRECT REPRESENTATION OF THE PROPERTY LINES TO THE BEST OF MY KNOWLEDGE AND BELIEF.

DAVID F. ABELL WISCONSIN REGISTERED LAND SURVEYOR, S-1596

1989 JOB NUMBER - 89219 NOTE: THIS IS NOT A CERTIFIED COPY UNLESS SEALED.