


**ABELL
SURVEYING & MAPPING
DEHAVAN, WISCONSIN 53115
414-728-6737**

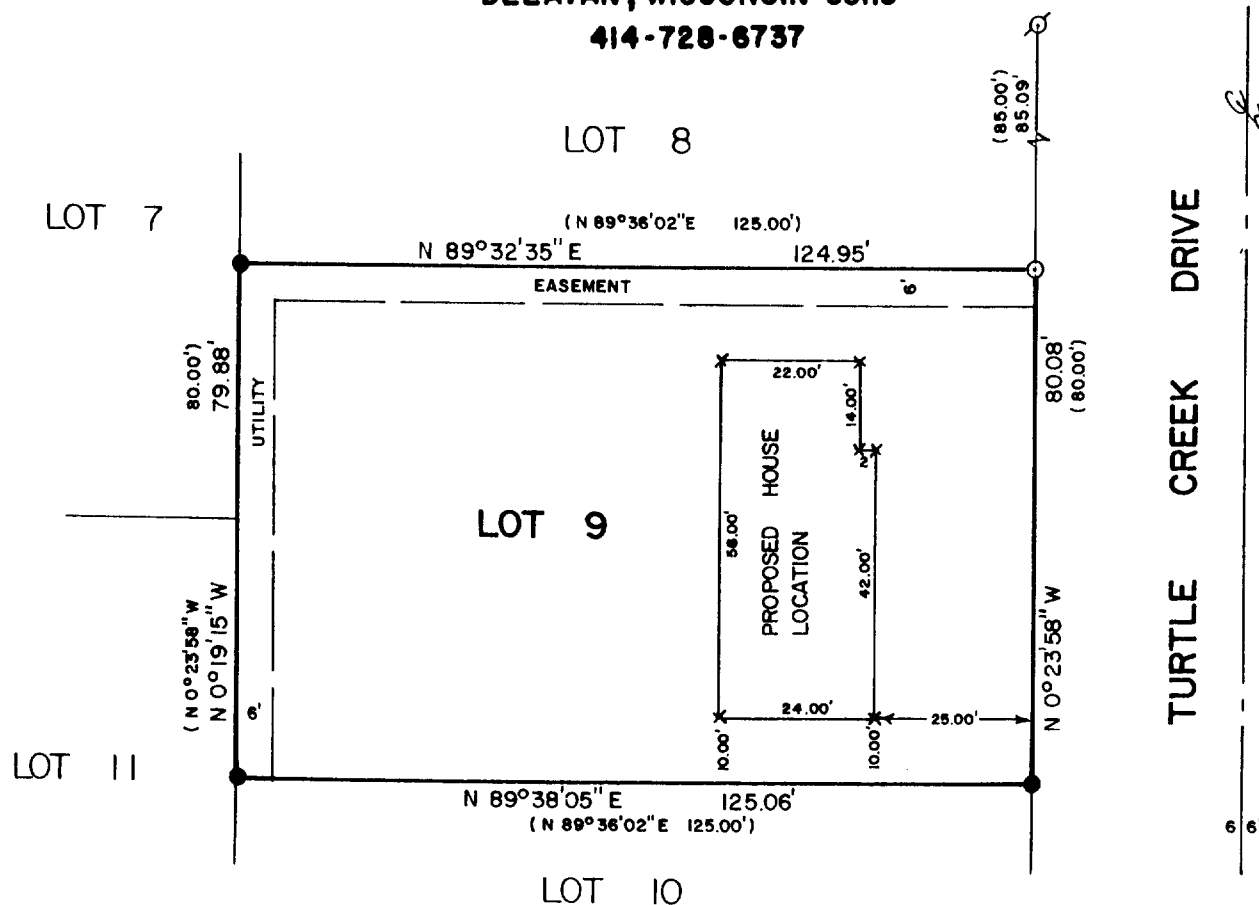


PLAT OF SURVEY OF

LOT 9, TURTLE CREEK SUBDIVISION, LOCATED IN THE
CITY OF DELAVAN, WALWORTH COUNTY, WISCONSIN.

ORDERED BY: SOUTHEASTERN WISCONSIN HOUSING CORP.
P.O.B. 421
BURLINGTON, WI. 53105

NOTE: THE BEARING ON THE EAST LINE OF LOT 9
IS ASSUMED N 0°23'58" W AS SHOWN ON
THE SUBDIVISION PLAT.

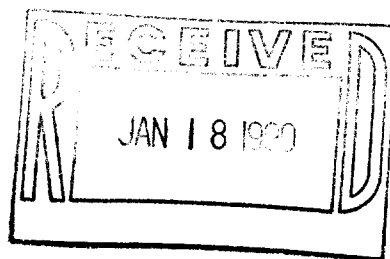

SCALE - 1"=30'

LEGEND

- ⊙ - IRON PIPE FOUND
- - IRON ROD FOUND
- - IRON ROD SET
- () - RECORDED AS
- x - 60 PENNY SPIKE SET

I, DAVID F. ABELL, DO HEREBY CERTIFY
THAT I HAVE SURVEYED THE PROPERTY
HEREON DESCRIBED ACCORDING TO THE
OFFICIAL RECORDS AND THAT THE PLAT
HEREON IS A CORRECT REPRESENTATION
OF THE PROPERTY LINES TO THE BEST OF
MY KNOWLEDGE AND BELIEF.

David F. Abell

DAVID F. ABELL
WISCONSIN REGISTERED LAND SURVEYOR, S-1596.

October 9, 1989

DATE JOB NUMBER - 89216

NOTE: THIS IS NOT A CERTIFIED COPY UNLESS SEALED.

XTC-9

C - DELAVAN