

DUNHAM SURVEYING, S.C.  
SURVEYING & SUBDIVIDING  
DELAVER, WISCONSIN 53115



N

FOURTH STREET

Scale - 1" = 20'

• = Iron Pipe Set  
# = Iron Pipe Found

Updating & recertification  
ordered by:  
Quality World, Carmin  
Heesters,  
111 East Geneva Street  
Delavan, WI 53115

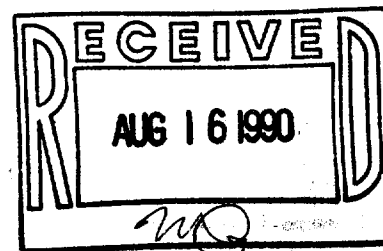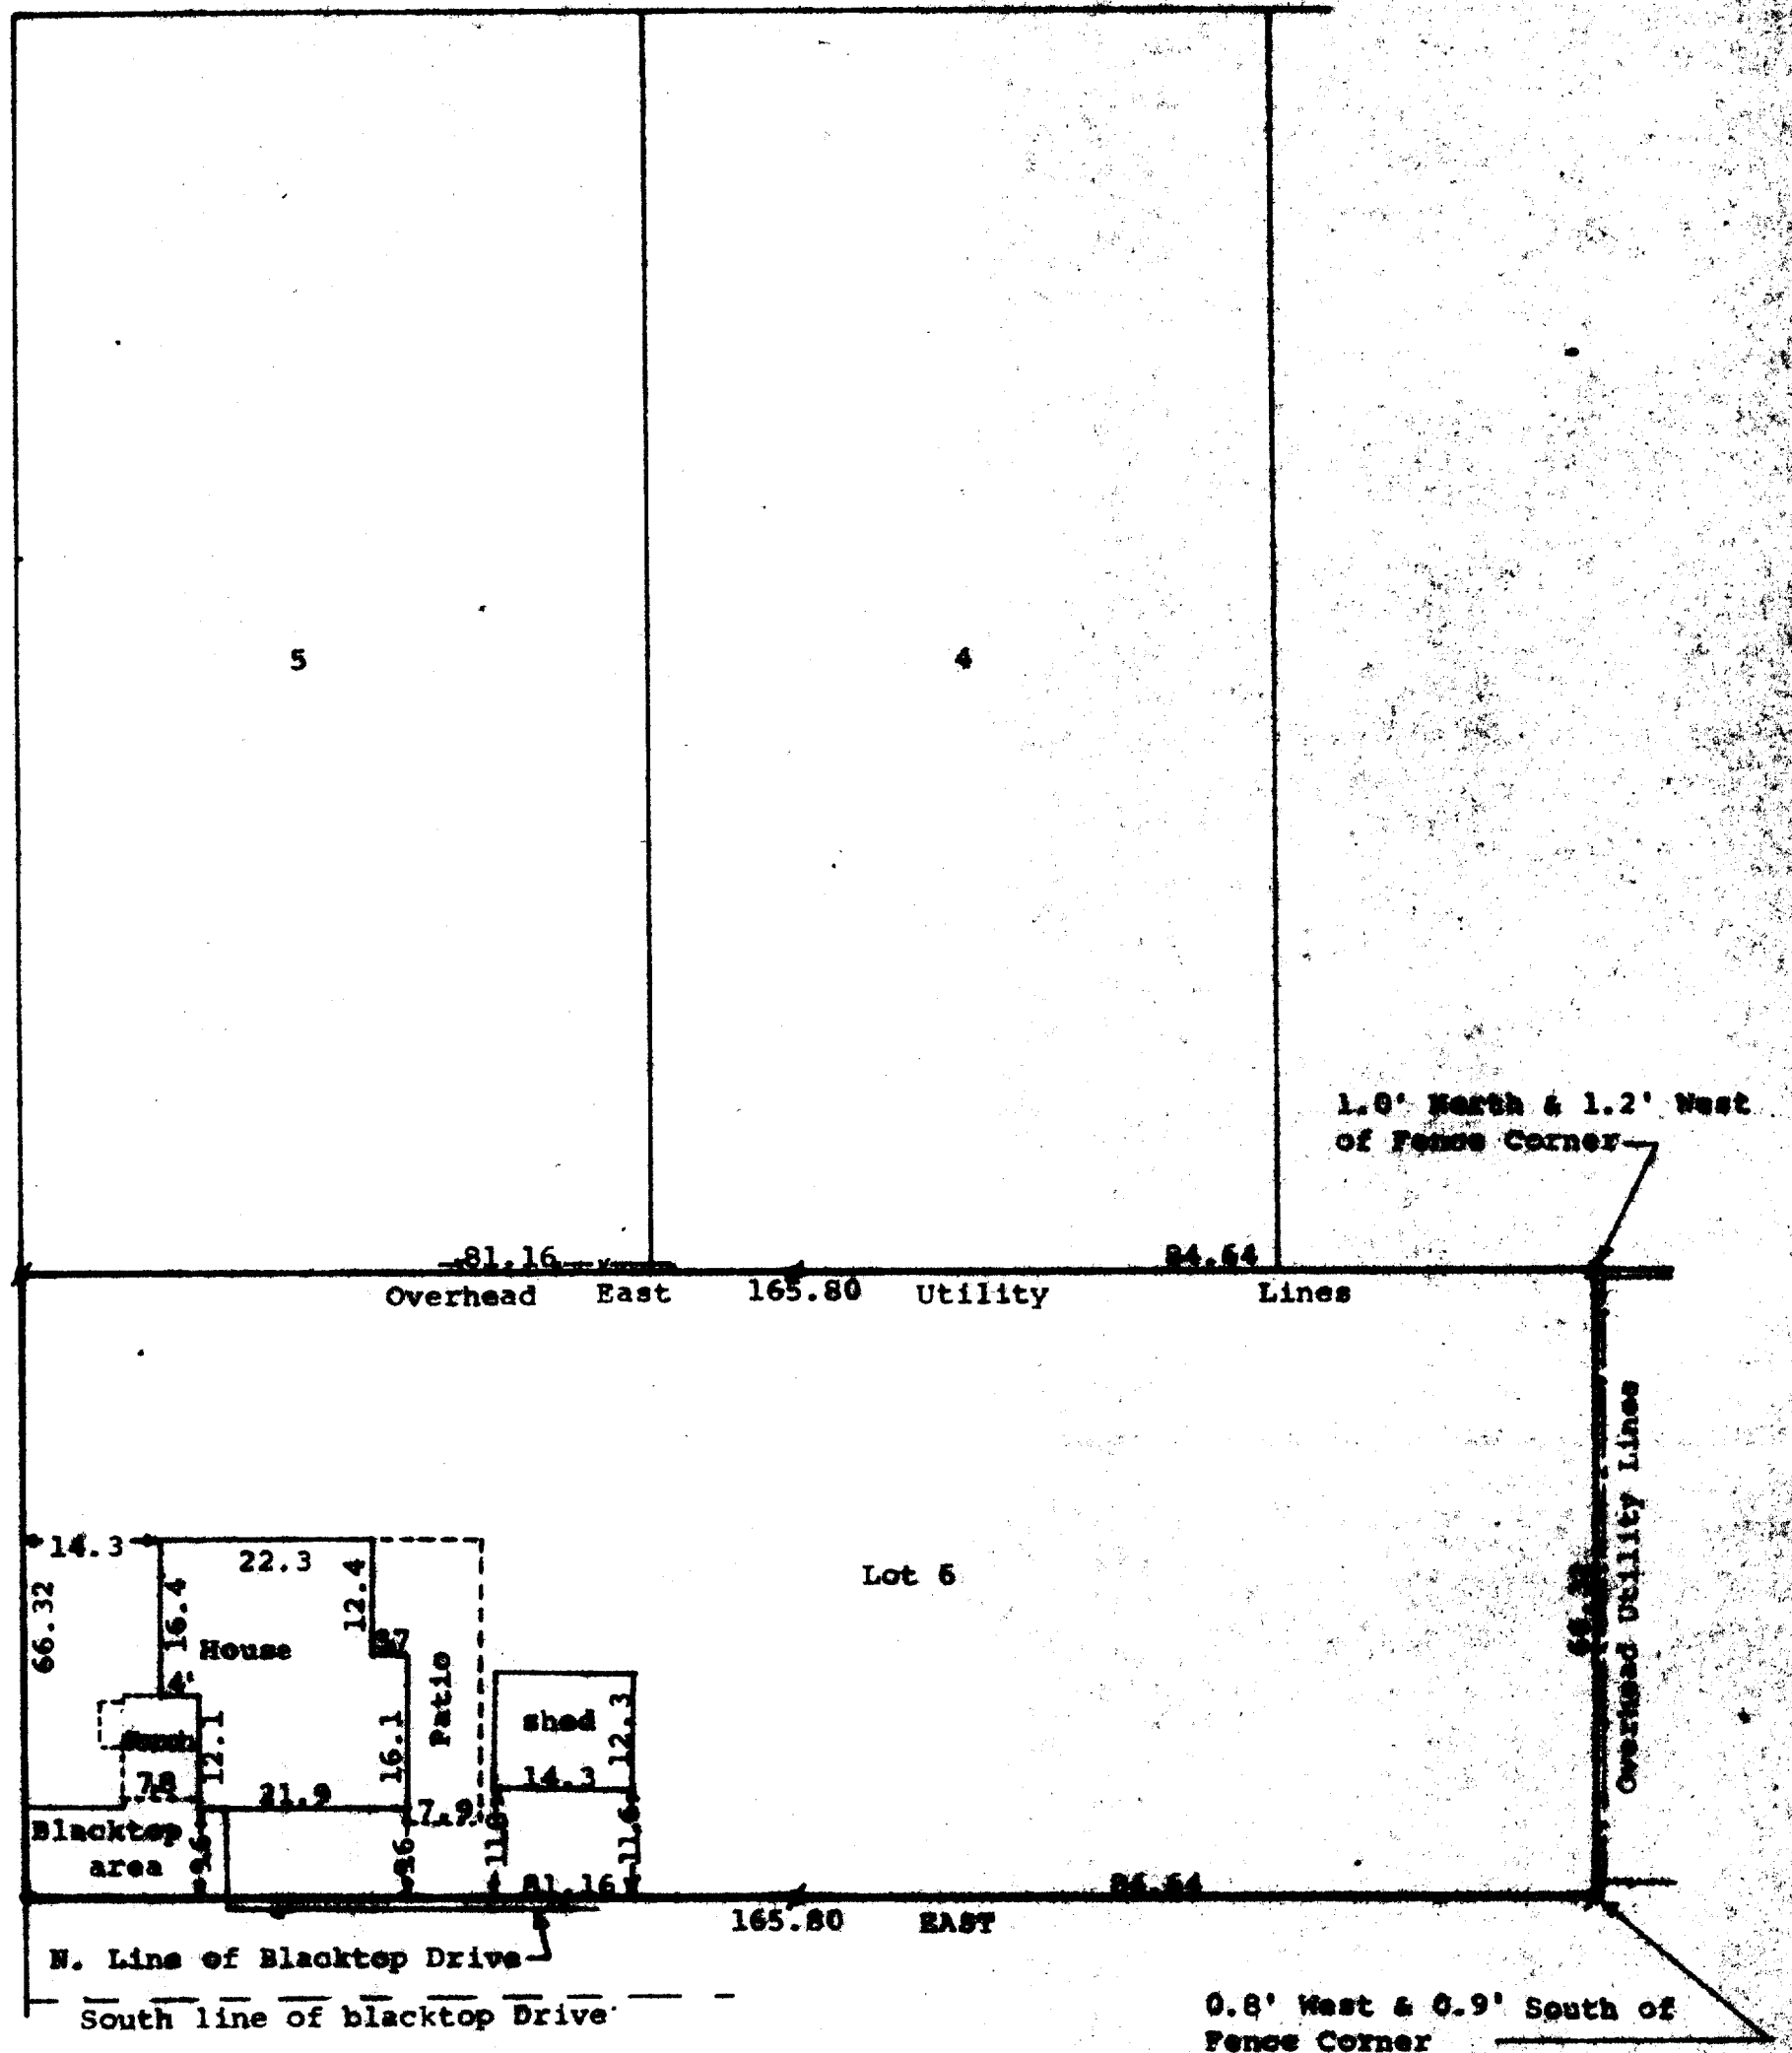


STATE OF WISCONSIN)  
COUNTY OF WALWORTH)

I, James M. Dunham, Surveyor, certify that I have surveyed the property described as follows:  
Lot 6, Block 3 in Passage, Aram and Dewie Addition to the Village (new City) of Delavan, according to a plat of record in the Office of the Register of Deeds for Walworth County, Wisconsin, and the above map is a true representation thereof and shows the size and location of the property, its exterior boundaries, the location and dimensions of all structures thereon, fences, apparent easements and roadways and visible encroachments, if any.  
This survey is made for the exclusive use of the present owners of the property, and also those who purchase, mortgage, or guarantee the title thereto within one (1) year from date hereof; and as to them I warrant the accuracy of said survey and map.  
May 19, 1978  
Recertified & Updated this 28th day of August, 1989

*James M. Dunham*  
James M. Dunham, Surveyor

*George T. Dunham*  
George T. Dunham, Surveyor

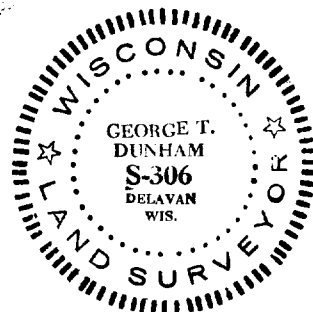

Survey # 002-9916

TAX KEY# XP 00033