


DUNHAM SURVEYING, S. C.
 SURVEYING & SUBDIVIDING
 DELAVAN, WISCONSIN 53115



Scale - 1" = 10'
 x = Cross in concrete found
 o = 1" Iron Pipe Found
 Survey ordered by: Harry F. Worth, Jr.
 Attorney at Law
 Elkhorn, WI 53121
 --- = Fence Line

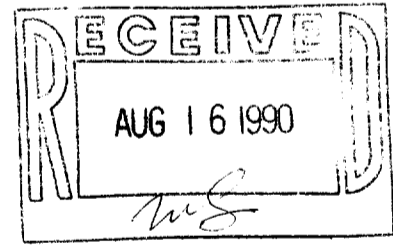

STATE OF WISCONSIN)ss
 COUNTY OF WALWORTH)


I, George T. Dunham, Surveyor, certify that I have surveyed the property described as follows:

A parcel of land located in Lots 1, 2 and 3 in Block 17 of Passage, Aram & Downie Addition to the Village, now City of Delavan, Walworth County, Wisconsin, described as follows: Beginning at the southwest corner of said Lot 1; thence northeasterly along the southeasterly line of said Lots 1, 2, and 3, 101.31 feet to an iron pipe; thence northwesterly 82.37 feet to an iron pipe on the northwesterly line of said Lot 3 and located 59.03 feet northeasterly of the northwest corner of said Lot 1; thence southwesterly along the northwesterly line of said Lots 1, 2, and 3, 59.03 feet to the northwest corner of said Lot 1; thence southerly along the west line of said Lot 1, 93.32 feet to the place of beginning.

and that the plat shown hereon is a correct representation thereof and shows the size and location of the property, its exterior boundaries, the location of all visible structures and dimensions of all principal buildings thereon, boundary fences, apparent easements, roadways and visible encroachments, if any, and that I have surveyed the property hereon described, according to the official records, to the best of my knowledge and belief.

Surveyed Dec. 29, 1989
 Plat drawn April 25, 1990

George T. Dunham
 George T. Dunham, Surveyor

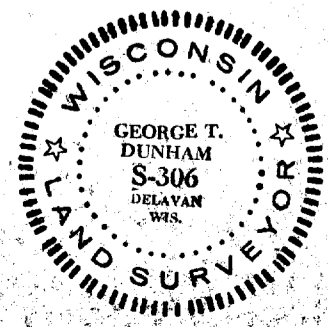

Survey # 002-999