



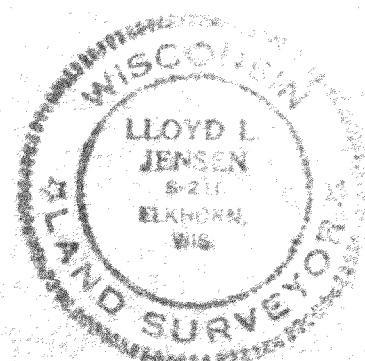

LEGEND

- - FOUND IRON PIPE
- - SET IRON ROD

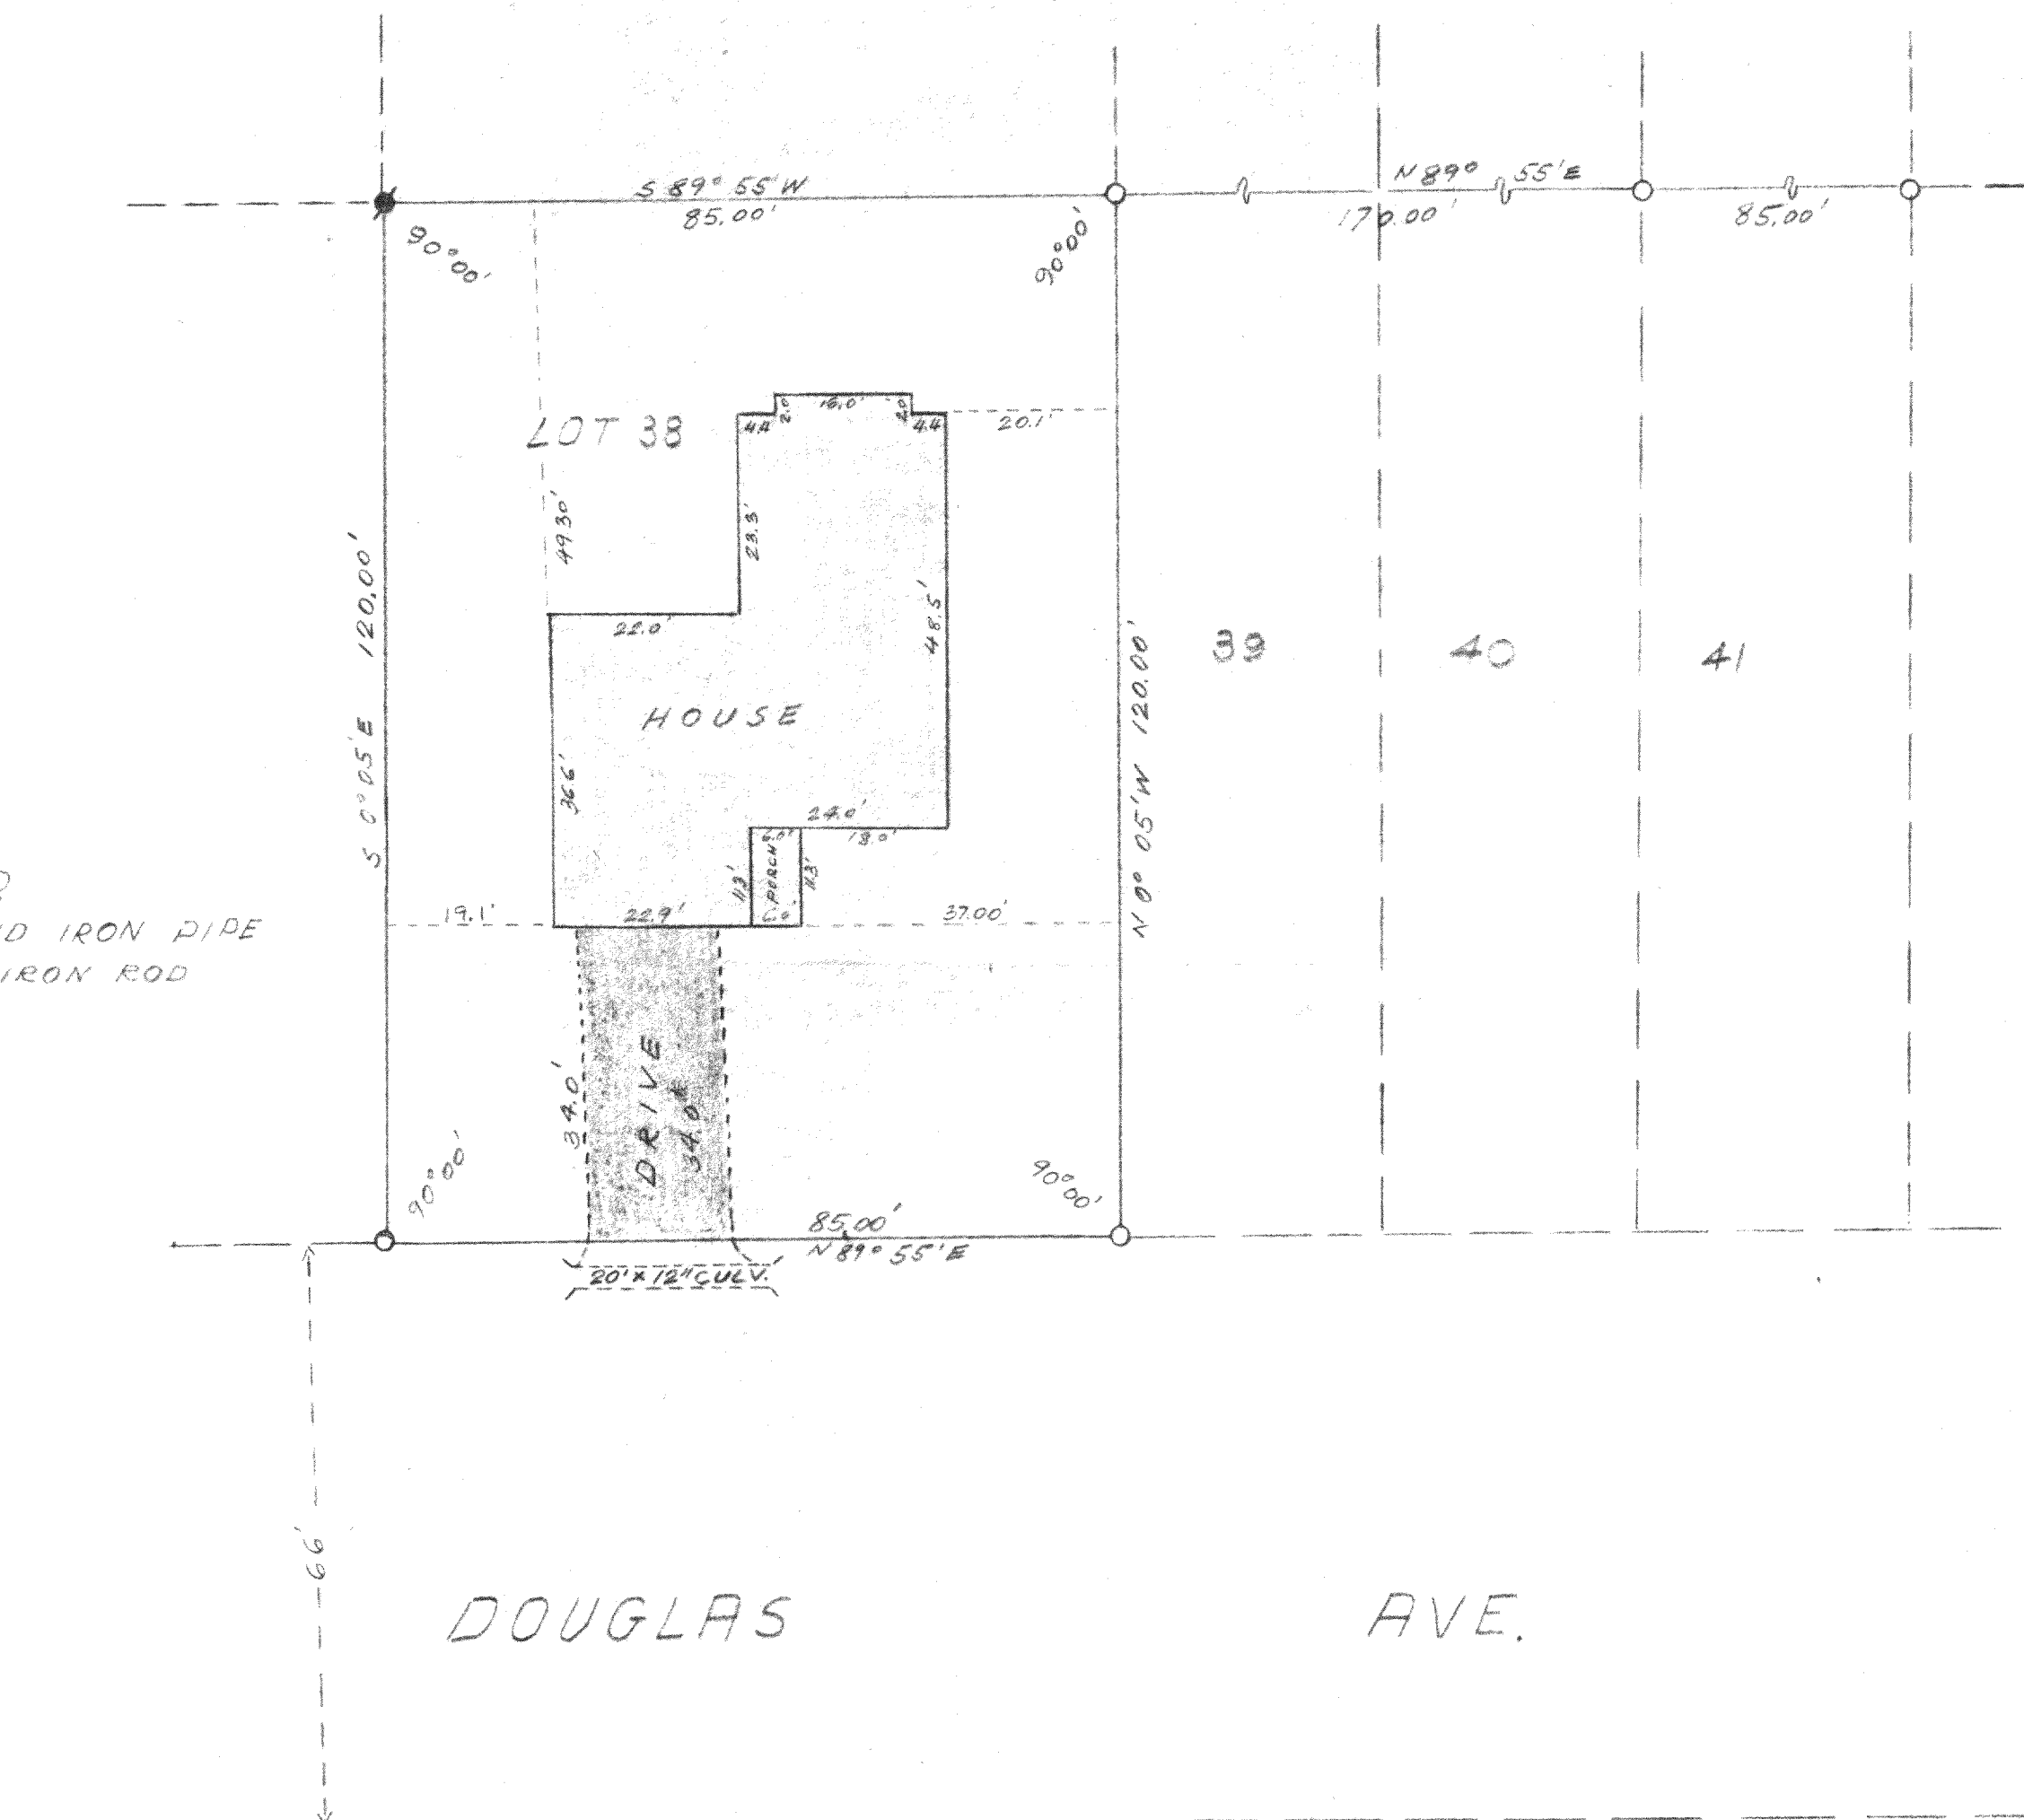

**PLAT OF SURVEY
OF**

LOT 38 TROYJENS SUBDIVISION
LOCATED IN THE SW 1/4 OF SECTION
19, T4N, R18E, VILLAGE OF EAST
TROY, WALWORTH COUNTY, WISCO-
NSIN

Lloyd L. Jensen
SURVEYOR

SCALE 1" = 20'

DATE APR. 4, 1975