

HAROLD H. KOLB

REGISTERED PROFESSIONAL LAND SURVEYOR
LAKE GENEVA, WISCONSIN

PLAT OF SURVEY OF

A parcel of land located in the Northeast 1/4 of Section 30 and in the Southeast 1/4 of Section 19, T 4 N, R 12 E, Village of East Troy, Walworth County, Wisconsin and described as follows;

to wit:

Commencing at the North 1/4 corner of said Section 30; thence S 1° E 358.5 feet; thence N 81° E 776.34 feet; thence N 1° W 247.52 feet to the place of beginning; thence continue N 1° W 195.00 feet; thence N 88° 41' E 99.00 feet; thence S 0° 50' E 195.00 feet; thence S 88° 41' W 98.40 feet to the place of beginning.

CLAYTON AVENUE

BELLVIEW AVENUE



LEGEND


- ⊗ - IRON PIPE FOUND
- - IRON PIPE PLACED
- - CONCRETE MONUMENT
- x - SPIKE

N 1° W 358.5'

North 1/4 Corner of Sec. 30-4-18

N 81° E 776.34'

MAIN STREET

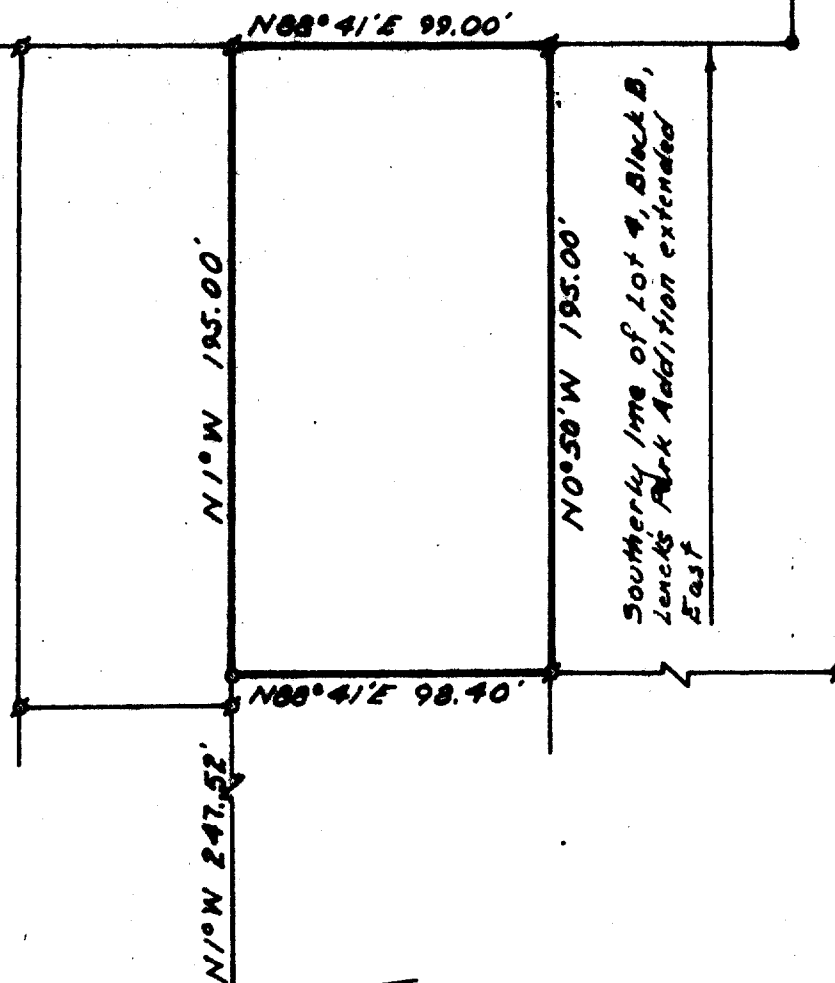

Southerly line of Lot 4, Block B, Levee Park Addition extended East

I, HAROLD H. KOLB, DO HEREBY CERTIFY THAT I HAVE SURVEYED THE PROPERTY HEREON DESCRIBED ACCORDING TO THE OFFICIAL RECORDS, AND THAT THE PLAT HEREON IS A CORRECT REPRESENTATION OF THE LOT LINES.

Harold H. Kolb

HAROLD H. KOLB

WISCONSIN REGISTERED LAND SURVEYOR, S-187

DATE April 22, 1965

3-15

18-11

UP-116A