
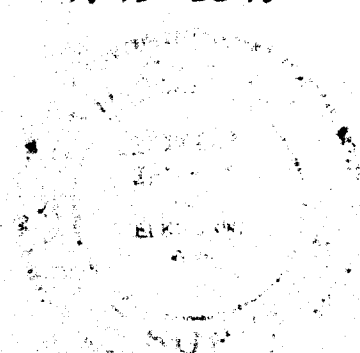


PLAT OF SURVEY

OF

LOT 18 OF LYNNDALE SUBDIVISION, LOCATED
IN THE SE $\frac{1}{4}$ NW $\frac{1}{4}$ & SW $\frac{1}{4}$ NW $\frac{1}{4}$ OF SECTION 20,
T4N R18E, VILLAGE OF EAST TROY, WAL. CO.
WISCONSIN.

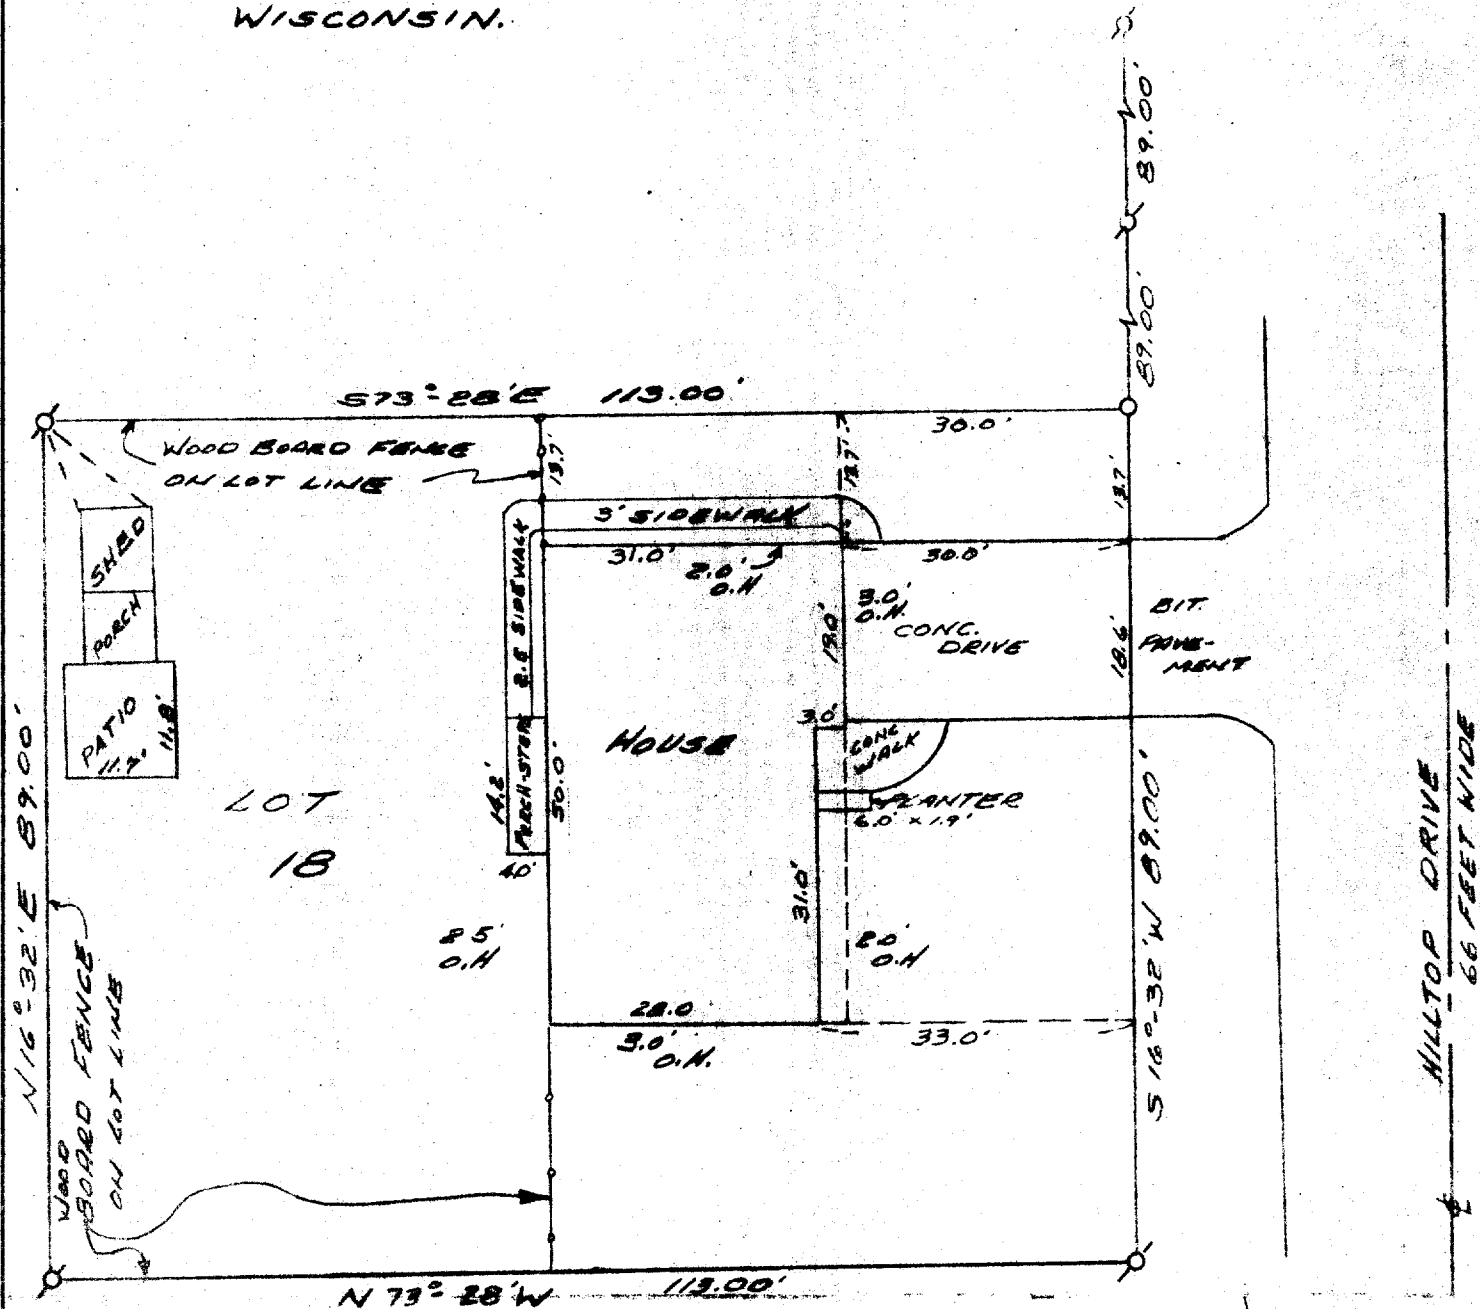

SURVEY AND PLAT BY
JENSEN & JOHNSON, INC.
CIVIL ENGINEERS AND SURVEYORS

Elkhorn, Wisconsin

LEGEND

- — Iron Pipe SET
- — Concrete Monument

Scale 1" = 20'

- — IRON PIPE FOUND
- O.H. — ROOF OVERHANG

WE CERTIFY: That we have surveyed the above described property and that the plat shown herein is an accurate survey and a true representation thereof and correctly shows the exterior boundary lines and all divisions of said property, and all buildings located thereon.

Date MARCH 1948

Lloyd L. Jensen
LLOYD L. JENSEN,

Wisconsin Registered Land Surveyor, No. 8-211

B-156 J