

Plat of Survey

Lot 22, Moore's Village Shores, a subdivision of part of the NW 1/4 of the NW 1/4 and the SW 1/4 of the NW 1/4 Section 29, and parts of the NE 1/4 of the NE 1/4 and the SE 1/4 of the NE 1/4 Section 30, all in T.4N., R.18E., of the 4th P.M., Village of East Troy, Walworth County, Wisconsin.

— LEGEND —


- DENOTES 2" DIA. IRON PIPE FOUND
- DENOTES 1" DIA. IRON PIPE FOUND
- DENOTES 3/4" DIA. IRON PIPE SET

SCALE: 1" = 30'


JOB NO. 77079

AUGUST 26, 1977

FOR: C-MAC BUILDING
EAST TROY, WI 53120

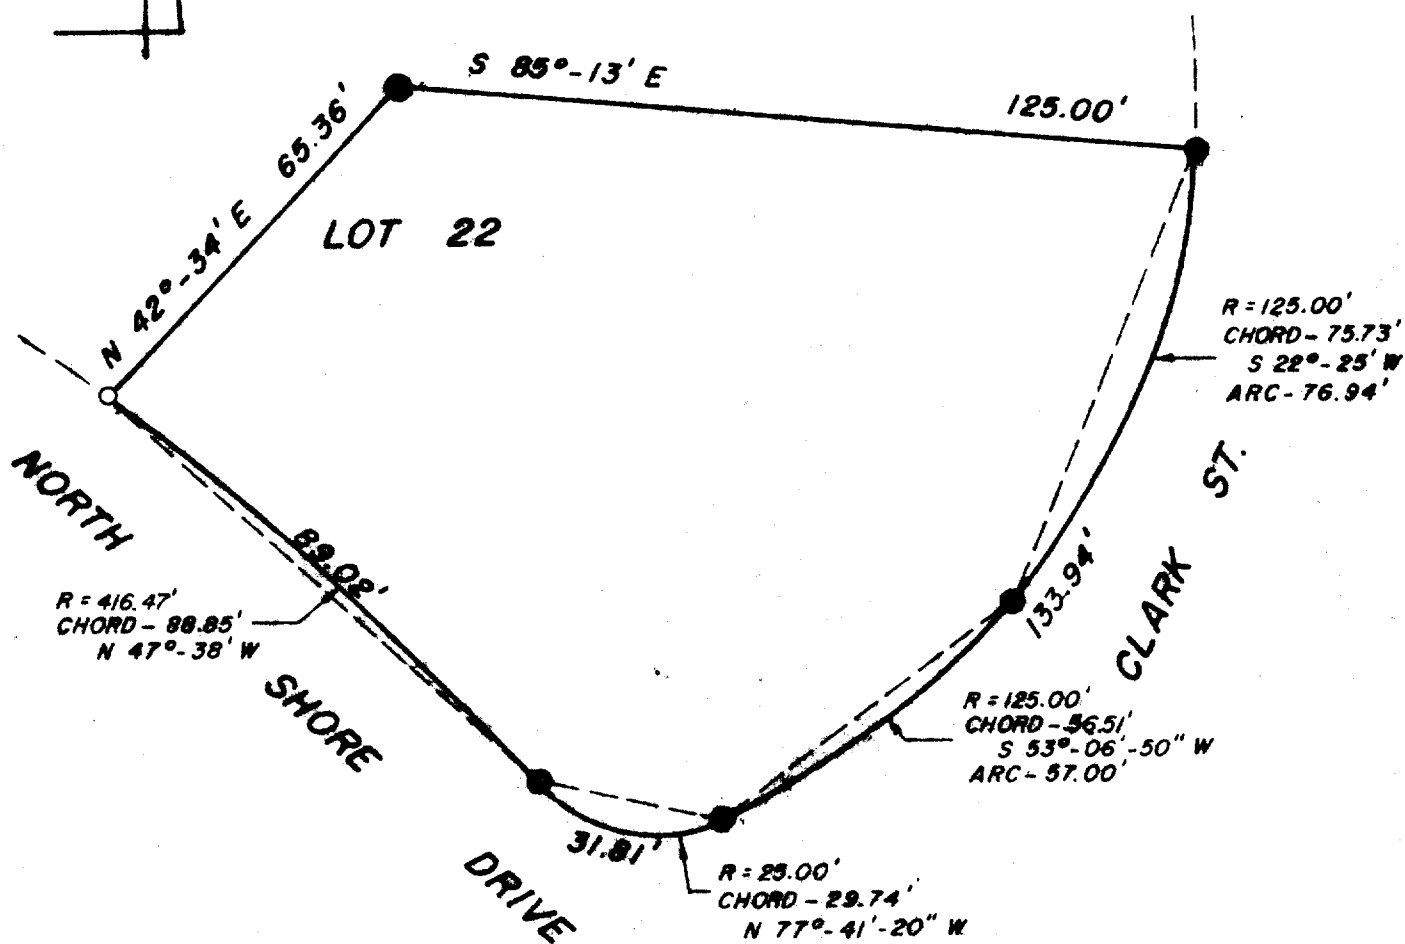

SURVEYOR'S CERTIFICATE: I HEREBY CERTIFY THAT THE LANDS DEPICTED HEREON HAVE BEEN SURVEYED UNDER MY DIRECTION AND THAT THE PLAT HEREON DRAWN IS A CORRECT REPRESENTATION OF SAID SURVEY.

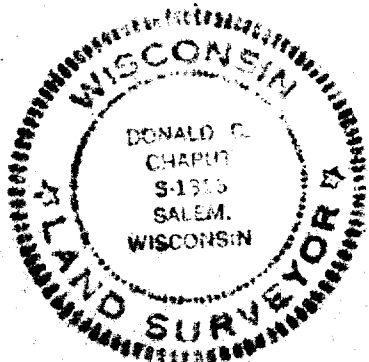

Donald C. Chaput

DONALD C. CHAPUT
LAND SURVEYOR S-1316
SALEM, WI