



Plat of Survey

Survey For: MIKE BOWER
Location: East Troy, WI

Description: All that part of the North East 1/4 of Section 19, Town 4 North, Range 18 East, in the Town of East Troy, Walworth County, Wisconsin, bounded and described as follows:

Commencing at the East 1/4 corner of said Section 19 thence North along the East line of said North East 1/4 Section, 330.00 feet to the point of beginning of the parcel to be described; thence continuing North, along said East line, 198.00 feet to a point, thence West at right angles to said East line, 858.00 feet to a point; thence South and parallel to said East line, 198.00 feet to a point; thence East 858.00 feet to the East line of said 1/4 Section and the point of beginning. Containing 3.9 Acres.

NOTE: BECAUSE OF LACK OF BETTER EVIDENCE NORTH & SOUTH LOT LINES WERE SET AT 90 DEGREES TO THE 1/4 LINE. TITLE CO. SHOULD BE CONTACTED FOR VERIFICATION.

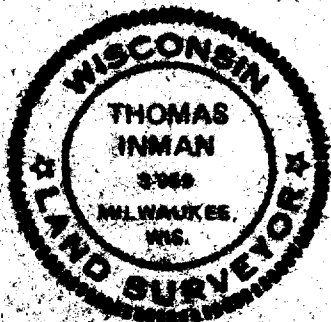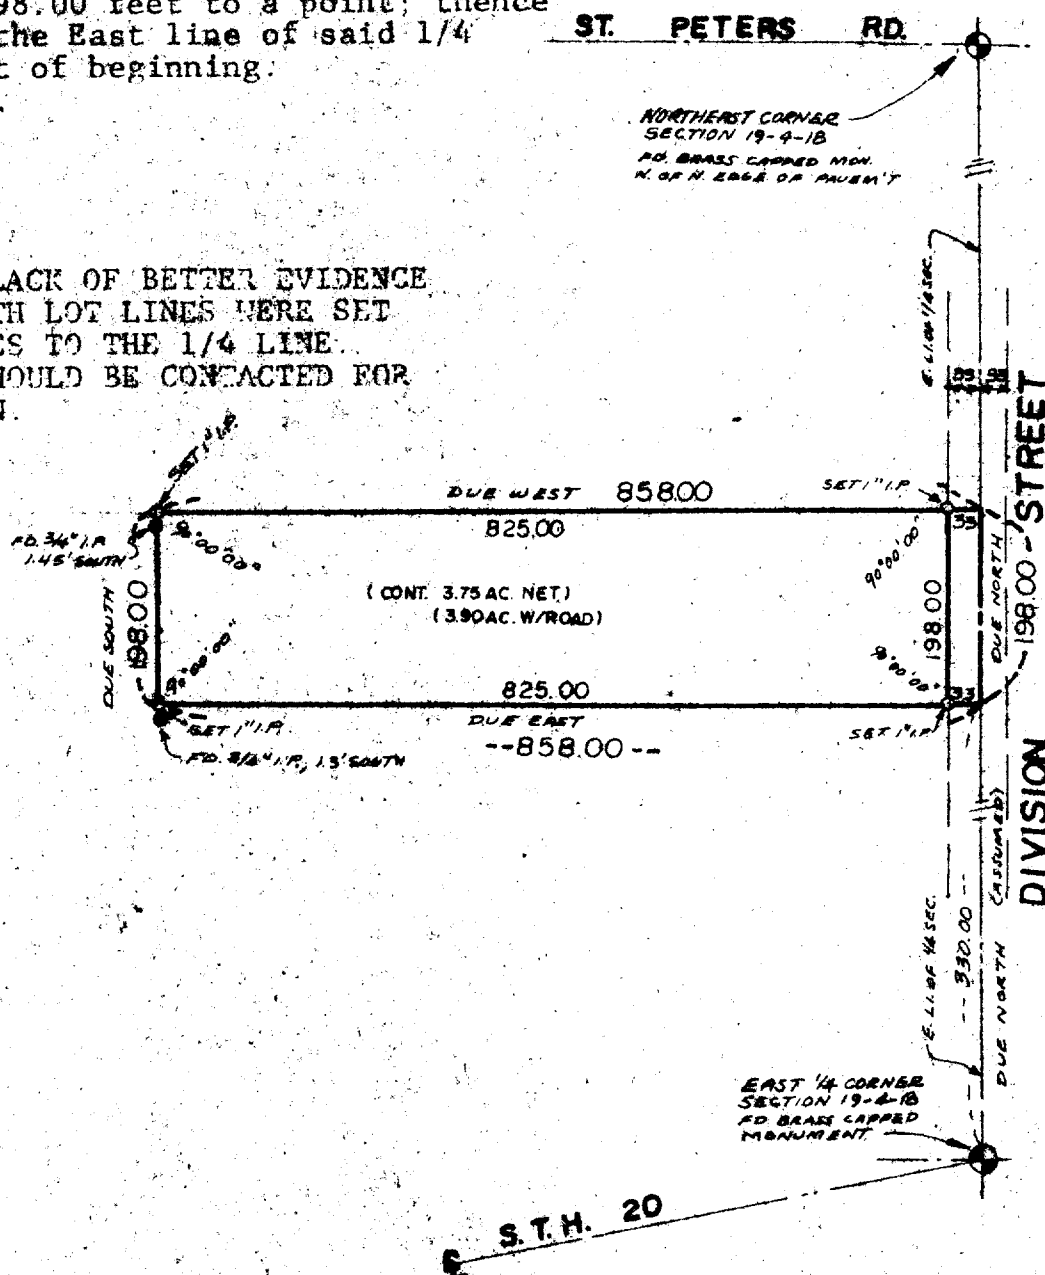

INMAN SURVEY

WEST OFFICE:
P.O. BOX 284
EAST TROY, WI 53120
(414) 642-3113

EAST OFFICE:
11221 W. FOREST HOME AVE.
MILWAUKEE, WI 53130
(414) 425-2080

SURVEY CERTIFICATE

I, Thomas Inman, State of Wisconsin, Milwaukee County, ss, I certify that I have surveyed the above described (property) and the above map is a true representation thereof and shows the size and location of the Property, its exterior boundaries, the location and dimensions of all visible structures thereon, fences, apparent easements and roadways and visible encroachments, if any.

This survey is made for the exclusive use of the present owners of the Property, and also those who purchase, mortgage, or guarantee the title thereto within one (1) year from date hereof:

THOMAS INMAN, Registered Land Surveyor

DATE: 2/13/80

JOB NO.: 8180 3-220

XUP-5