


Sidler Surveying Company

709 Odana Lane, Madison, Wisconsin

(608)-274-4714

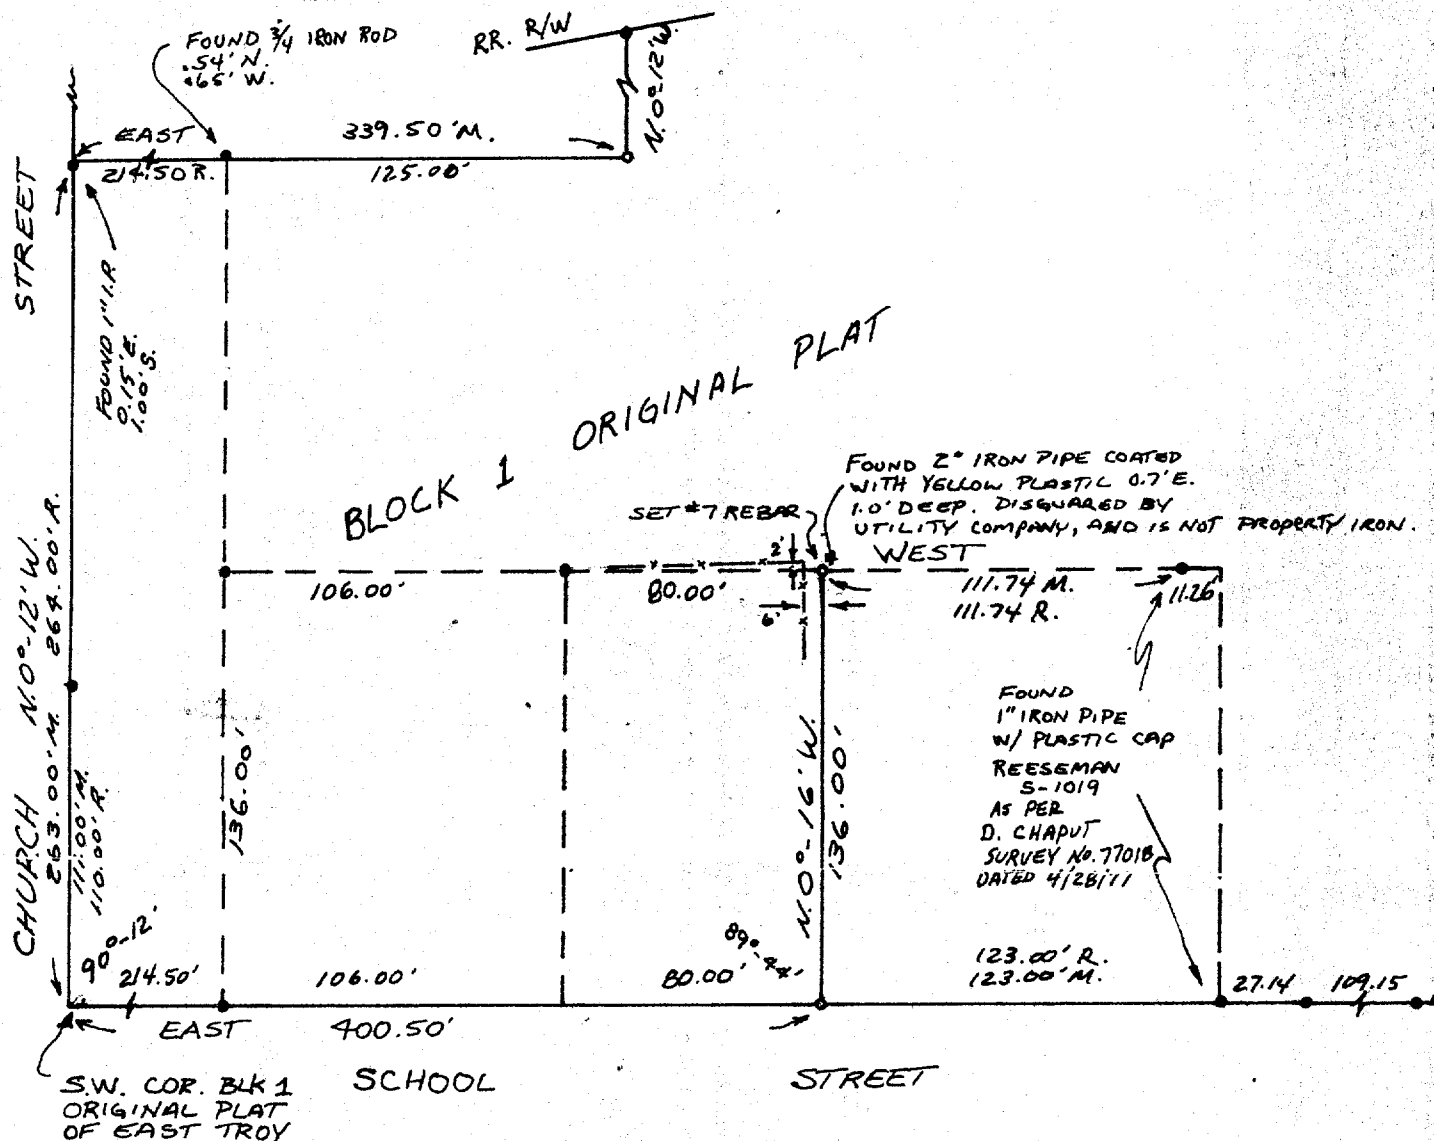

CERTIFICATE

I, Mark P. Sidler, Registered Land Surveyor, S-1519 of the State of Wisconsin, do hereby certify that the intent of this survey was to reset property irons obliterated by construction work. That I have surveyed and mapped Part of Block 1 of the Original Plat of East Troy, Walworth County, Wisconsin, according to official records and that the Plat shown hereon is a true and correct representation thereof.



Mark P. Sidler
Mark P. Sidler RLS-1519

OWNER / CLIENT

SCHLOBOHM CONSTRUCTION

RT 1

DEERFIELD, WISCONSIN

DATE 7/24/80 SSC-80-1059

LEGEND

• - FOUND IRON STAKE

o - SET #7 REBAR 24" LONG

R - RECORDED DISTANCE

M - MEASURED DISTANCE

-x- FENCE

ROP-2A

OP-9, 12 & 13