


RONALD H. ZIMMERMAN
REGISTERED LAND SURVEYOR

PLAT OF SURVEY

FOR

DAVID & KIM PIQUETT

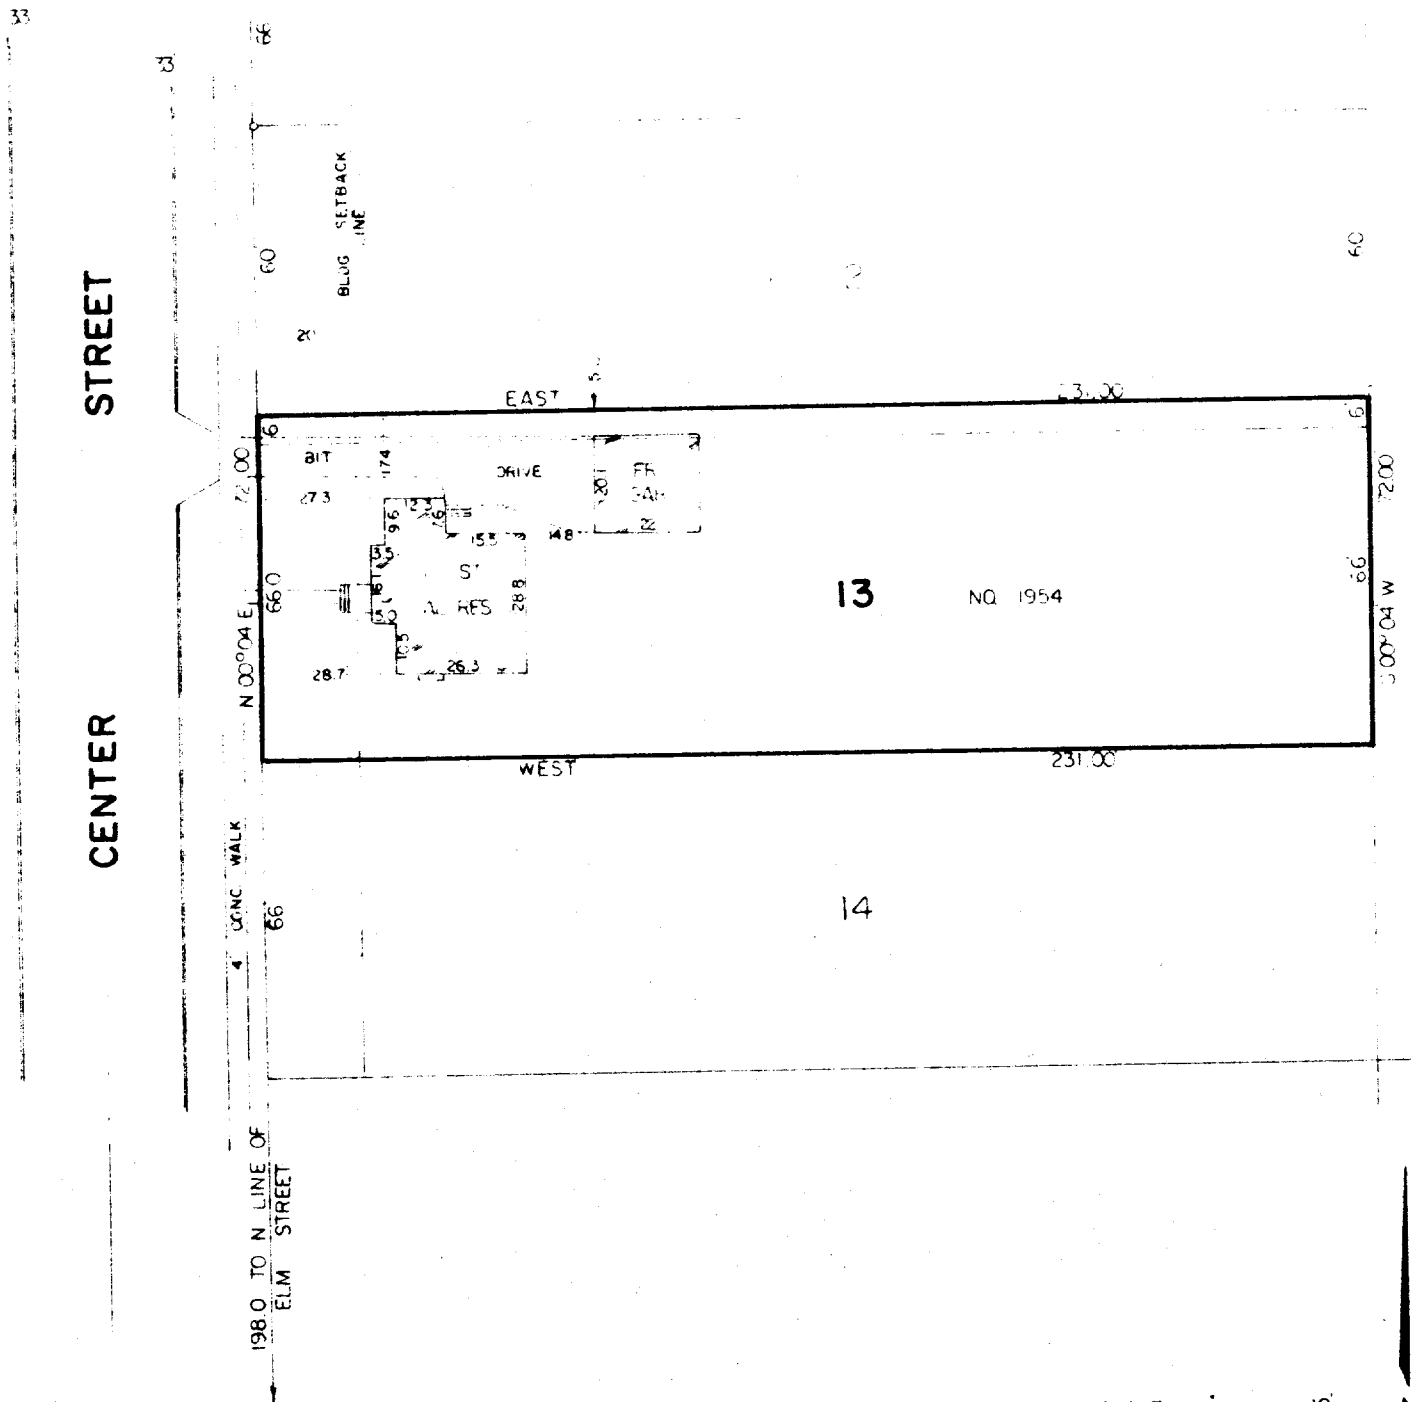

SCALE 1" = 40'

o - INDICATES IRON PIPE,
FOUND

Lot 13 and Lot 12 except the North 60 feet,
Block 2, North View Addition to the Village
of East Troy, being a portion of the North-
east 1/4 of the Southeast 1/4 of Section 19.
Town 4 North, Range 18 East, Village of East
Troy, Walworth County, Wisconsin.

CERTIFICATION

STATE OF WISCONSIN } SS
COUNTY OF WAUKESHA }

I HAVE SURVEYED THE ABOVE DESCRIBED PROPERTY AND THE ABOVE MAP IS A TRUE REPRESENTATION THEREOF AND SHOWS THE SIZE AND LOCATION OF THE PROPERTY, ITS EXTERIOR BOUNDARIES, THE LOCATION AND DIMENSIONS OF ALL VISIBLE STRUCTURES THEREON, FENCES, APPARENT EASEMENTS AND ROADWAYS AND VISIBLE ENCROACHMENTS, IF ANY.

THIS SURVEY IS MADE FOR THE EXCLUSIVE USE OF THE PRESENT OWNERS OF THE PROPERTY, AND ALSO THOSE WHO PURCHASE, MORTGAGE, OR GUARANTEE THE TITLE THERETO WITHIN ONE (1) YEAR FROM DATE HEREOF, AND AS TO THEM I WARRANT THE ACCURACY OF SAID SURVEY AND MAP.

DATE AUGUST 24 1982

RONALD H. ZIMMERMAN

S - 868

