


Plat of Survey

Survey For: A & W ROOT BEER
Location: COUNTY TRUNK HIGHWAY "ES"

Description: Commencing at the intersection of the centerline of the Milwaukee-Beloit Road (now known as County Trunk Highway 18) and the North and South 1/4 Section line of Section 30, Township 4 North, Range 18 East, thence South 82°45' West along the centerline of said highway 300 feet to a point on said centerline which is the place of beginning of this description; thence South parallel to said Quarter line 220.0 feet to an iron stake; thence North 82°45' East 50 feet to a point; thence North and parallel with said North and South quarter Section line 220.0 feet to the centerline of aforesaid highway; thence South 82°45' West along the centerline of said highway 50 feet to the place of beginning.

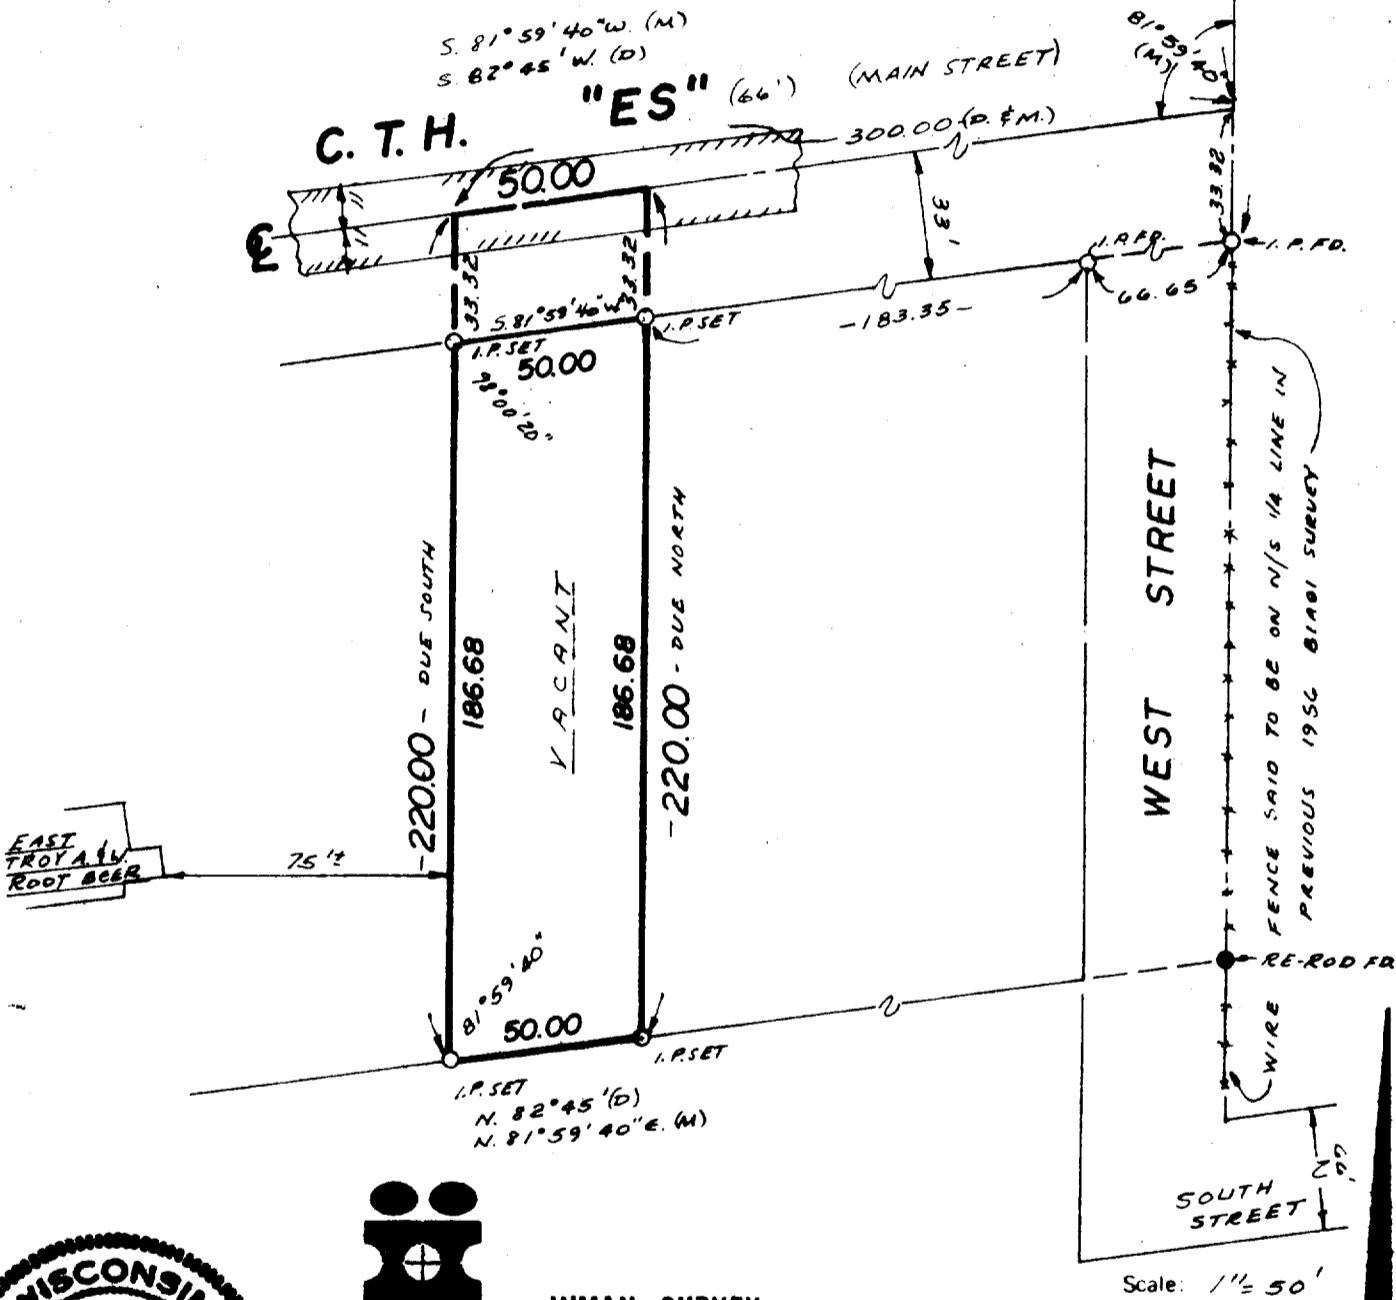

INMAN SURVEY

WEST OFFICE:
P.O. BOX 286
EAST TROY, WI 53120
(414) 642-3113

EAST OFFICE:
11221 W. FOREST HOME AVE.
MILWAUKEE, WI 53130
(414) 425-2060

SURVEY CERTIFICATE

State of Wisconsin) ss I certify that I have surveyed the above described (property) and the above map is a true representation thereof and shows the size and location of the Property, its exterior boundaries, the location and dimensions of all visible structures thereon, fences, apparent easements and roadways and visible encroachments, if any.

This survey is made for the exclusive use of the present owners of the Property, and also those who purchase, mortgage, or guarantee the title thereto within one (1) year from date hereof;

Thomas Inman
THOMAS INMAN, Registered Land Surveyor

DATE: 6-15-81
JOB NO.: 9195

XUP-200

3-233