PLAT OF SURVEY


LOCATION:

1942 North Fremont, East Troy, Wisconsin

LEGAL DESCRIPTION: Lot 4 in Block 1 in S. B. EDWARDS ADDITION TO THE VILLAGE OF EAST TROY, Walworth County, Wisconsin.

July 26, 1985

Survey No. 64539

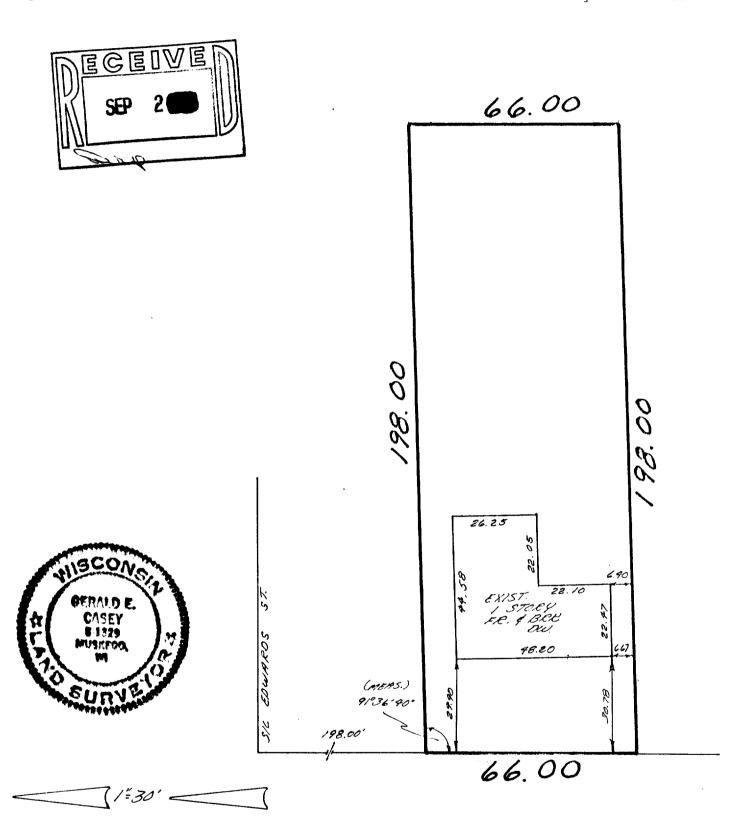

FREMONT ST.

66

METROPOLITAN SURVEY SERVICE, INC.

REGISTERED LAND SURVEYORS 11000 W. JANESVILLE RD. HALES CORNERS, WI 53130 529-5380

Montgage Inspection

Monumentation has been warred in accordance with A-5 5.01 (b) of the Wisconsin Administrative Code.

REA-4

THEREBY CERTIFY THAT THAVE SURVEYED THE ABOVE DESCRIBED PROPERTY AND THAT THE ABOVE MAP IS A TRUE REPRESENTATION THEREOF AND SHOWS THE SIZE AND LOCATION OF THE PROPERTY, ITS EXTERIOR BOUNDARIES. THE LOCATION OF ALL VISIBLE STRUCTURES AND DIMENSIONS OF ALL PRINCIPAL BUILDINGS THEREON, BOUNDARY FENCES, APPARENT EASEMENTS AND ROADWAYS AND VISIBLE ENCROACHMENTS, IF ANY.

THIS SURVEY IS MADE FOR THE EXCLUSIVE USE OF THE PRESENT OWNERS OF THE PROPERTY, AND ALSO THOSE WHO PURCHASE, MORTGAGE, OR GUARANTEE THE TITLE THERETO WITHIN ONE (1) YEAR FROM DATE HEREOF.

SIGNED STUDE LAND

Gerald E. Casey Registered Land Surveyor S-1329