

MAP OF SURVEY OF


PARCEL 1:

COMMENCING AT A POINT WHERE THE CENTERLINE OF HIGHWAY 15 INTERSECTS THE NORTH AND SOUTH 1/4 LINE OF SECTION 20, T4N, R12E; THENCE S89°47'W 120.00 FEET TO THE PLACE OF BEGINNING; THENCE S58°47'W 322.77 FEET; THENCE SOUTH 30.1 FEET; THENCE S31°12'E 354.65 FEET; THENCE N58°47'E 100.00 FEET; THENCE NORTH 31.2 FEET; THENCE S58°47'W 75 FEET; THENCE NORTH 138.5 FEET TO THE PLACE OF BEGINNING, VILLAGE OF EAST TROY, WALWORTH COUNTY, WISCONSIN.

PARCEL 2:

COMMENCING AT THE INTERSECTION OF THE NORTH AND SOUTH 1/4 SECTION LINE OF SECTION 20, T4N, R12E WITH THE CENTERLINE OF HIGHWAY 15; THENCE SOUTH 138.5 FEET; THENCE S58°47'W 71.23 FEET TO THE PLACE OF BEGINNING; THENCE S58°47'W 75 FEET; THENCE NORTH 138.5 FEET; THENCE N58°47'E 75 FEET; THENCE SOUTH 138.5 FEET TO THE PLACE OF BEGINNING, VILLAGE OF EAST TROY, WALWORTH COUNTY, WISCONSIN.

ORDERED BY: WISCONSIN OVEN CORPORATION
1. . . DOX-7
EAST TROY, WISCONSIN
05120

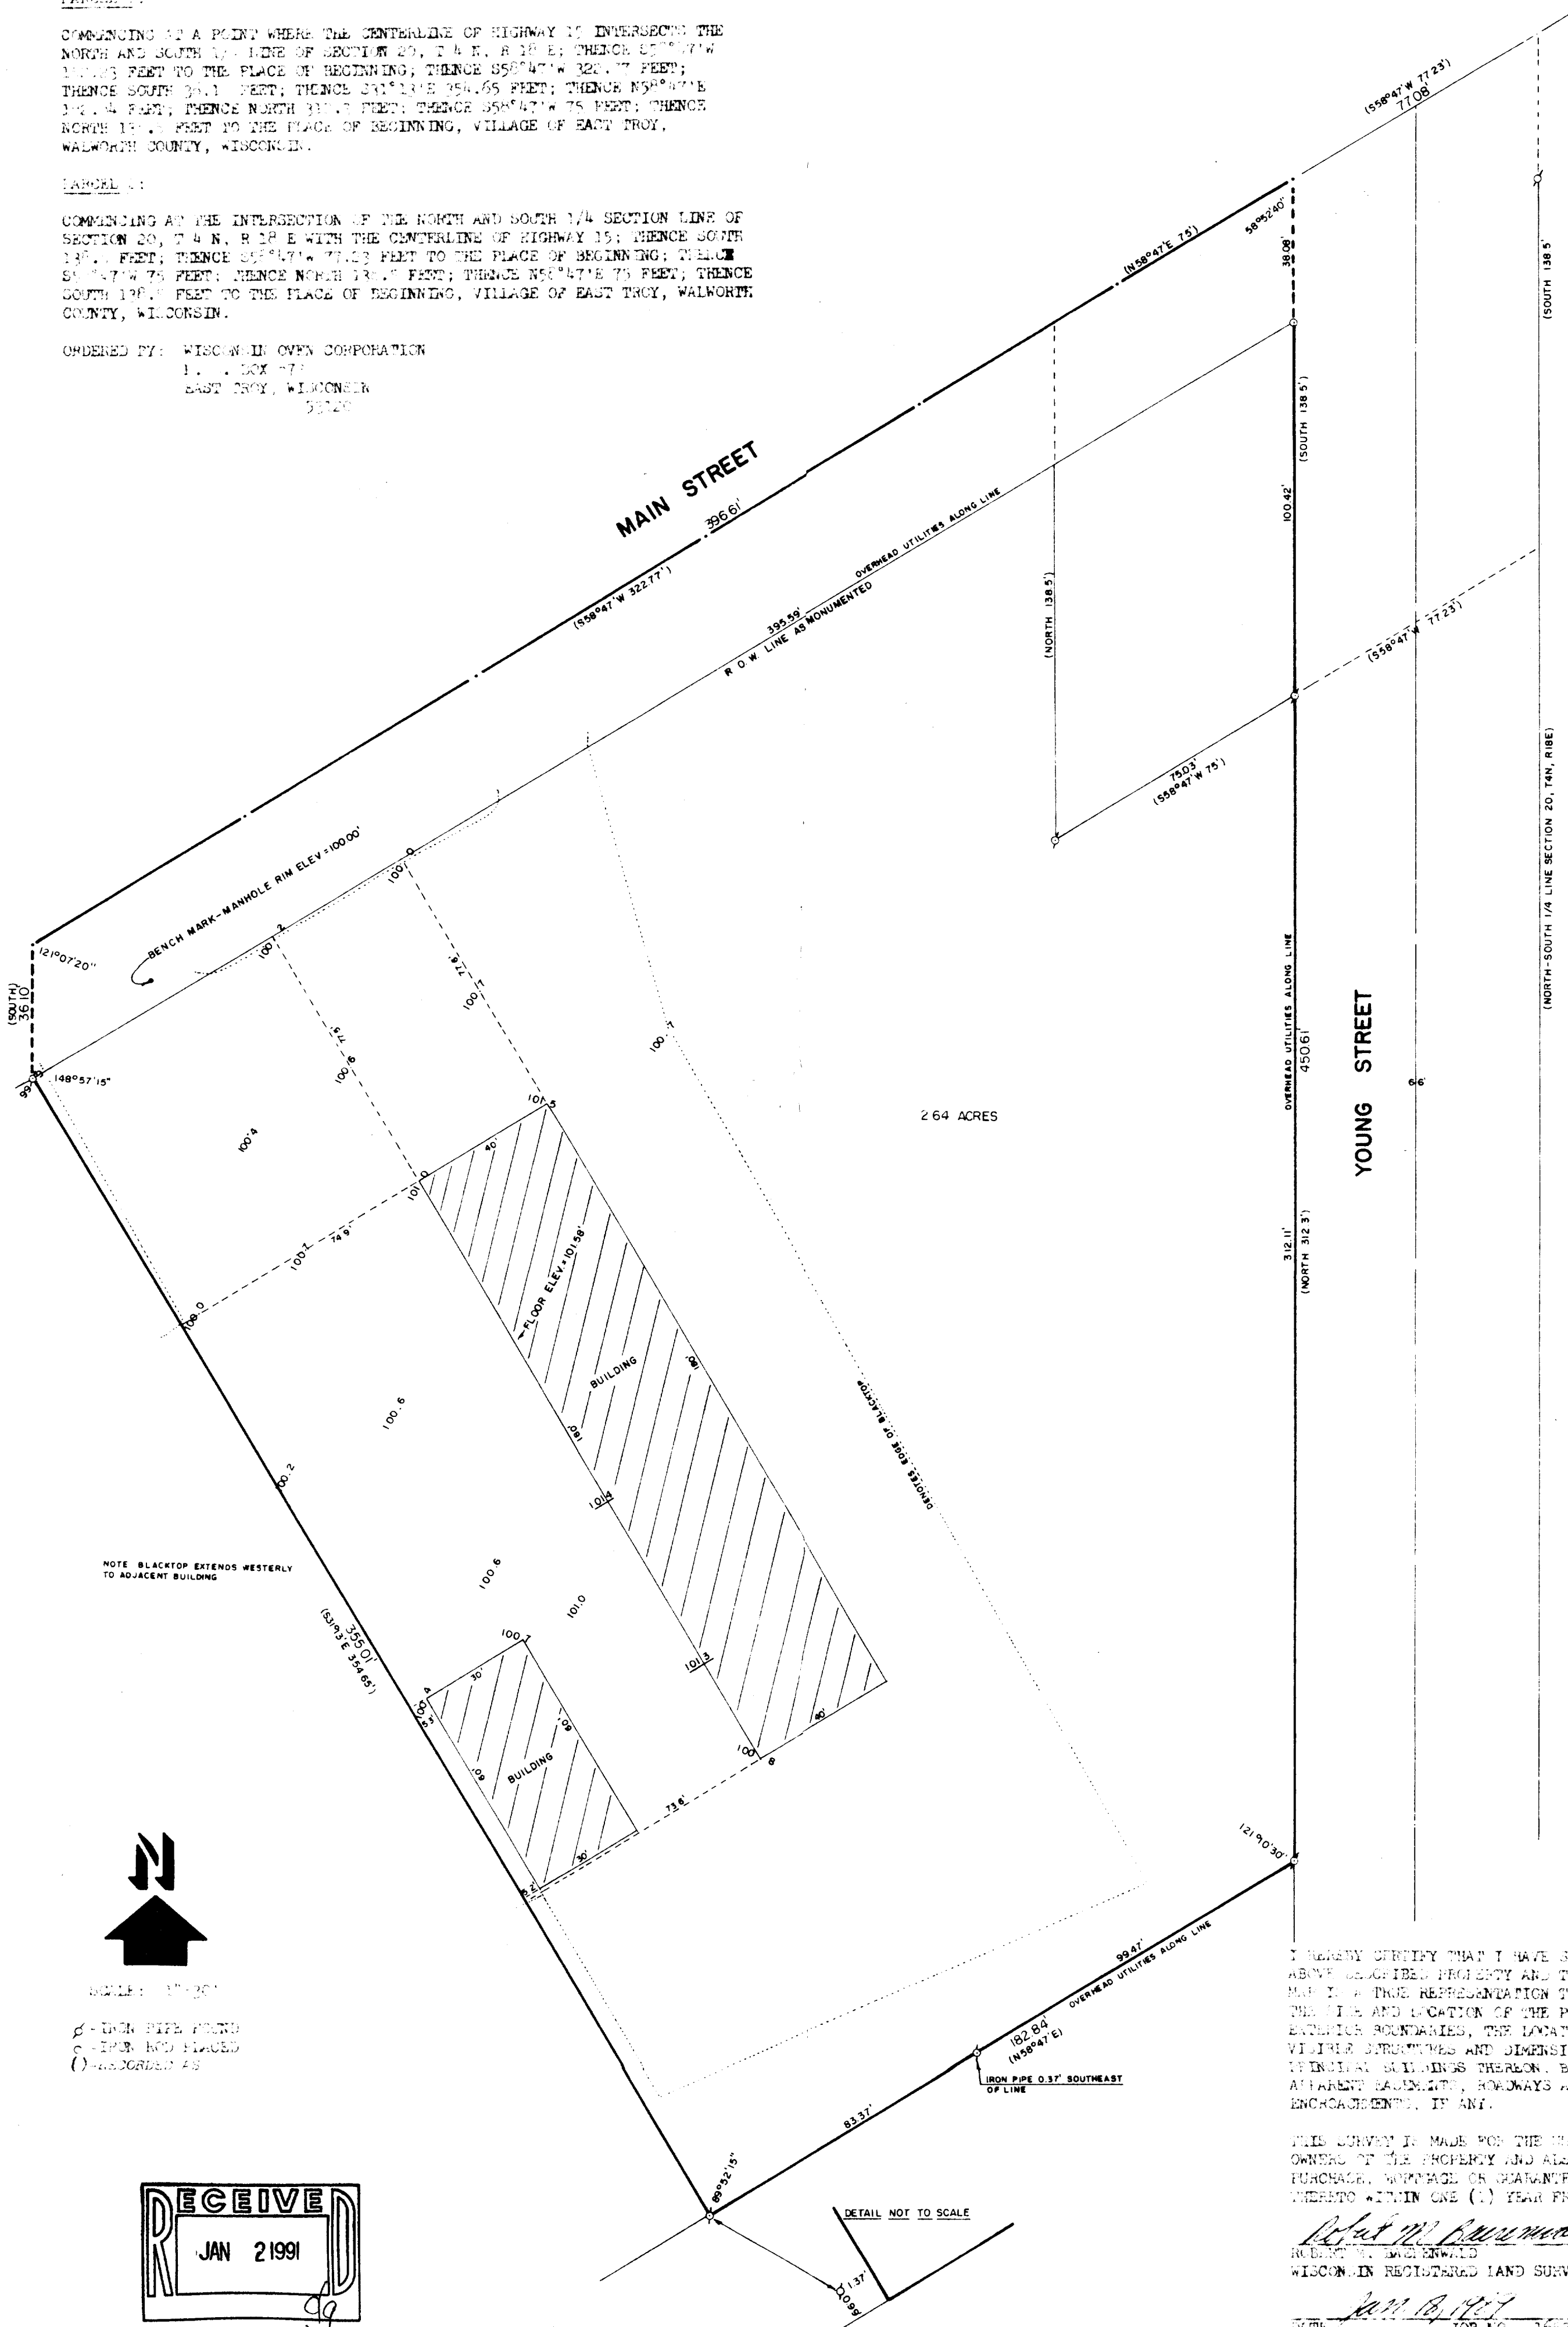

I HEREBY CERTIFY THAT I HAVE SURVEYED THE ABOVE DESCRIBED PROPERTY AND THAT THE ABOVE MAP IS A TRUE REPRESENTATION THEREOF AND SHOWS THE LINE AND LOCATION OF THE PROPERTY, ITS EXTERIOR BOUNDARIES, THE LOCATION OF ALL VISIBLE STRUCTURES AND DIMENSIONS OF ALL VISIBLE BUILDINGS THEREON, BOUNDARY FENCES, APPARENT EASEMENTS, ROADWAYS AND VISIBLE ENCROACHMENTS, IF ANY.

THIS SURVEY IS MADE FOR THE USE OF THE PRESENT OWNERS OF THE PROPERTY AND ALSO THOSE WHO PURCHASE, MORTGAGE OR GUARANTEE THE TITLE HEREIN WITHIN ONE (1) YEAR FROM DATE HEREOF.

Robert M. Bismuth
ROBERT M. BISMUTH
WISCONSIN REGISTERED LAND SURVEYOR, 11-1508
DATE: *Jan 19, 1991* JOB NO. 1549