



PLAT OF SURVEY


LOT 30 OF THE 2ND. ADDITION OF GLENN VIEW  
ESTATES SUBDIVISION, LOCATED IN THE  
NORTHWEST 1/4 OF SECTION 20, TOWN 4 NORTH,  
RANGE 18 EAST, VILLAGE OF EAST TROY,  
WALWORTH COUNTY, WISCONSIN.

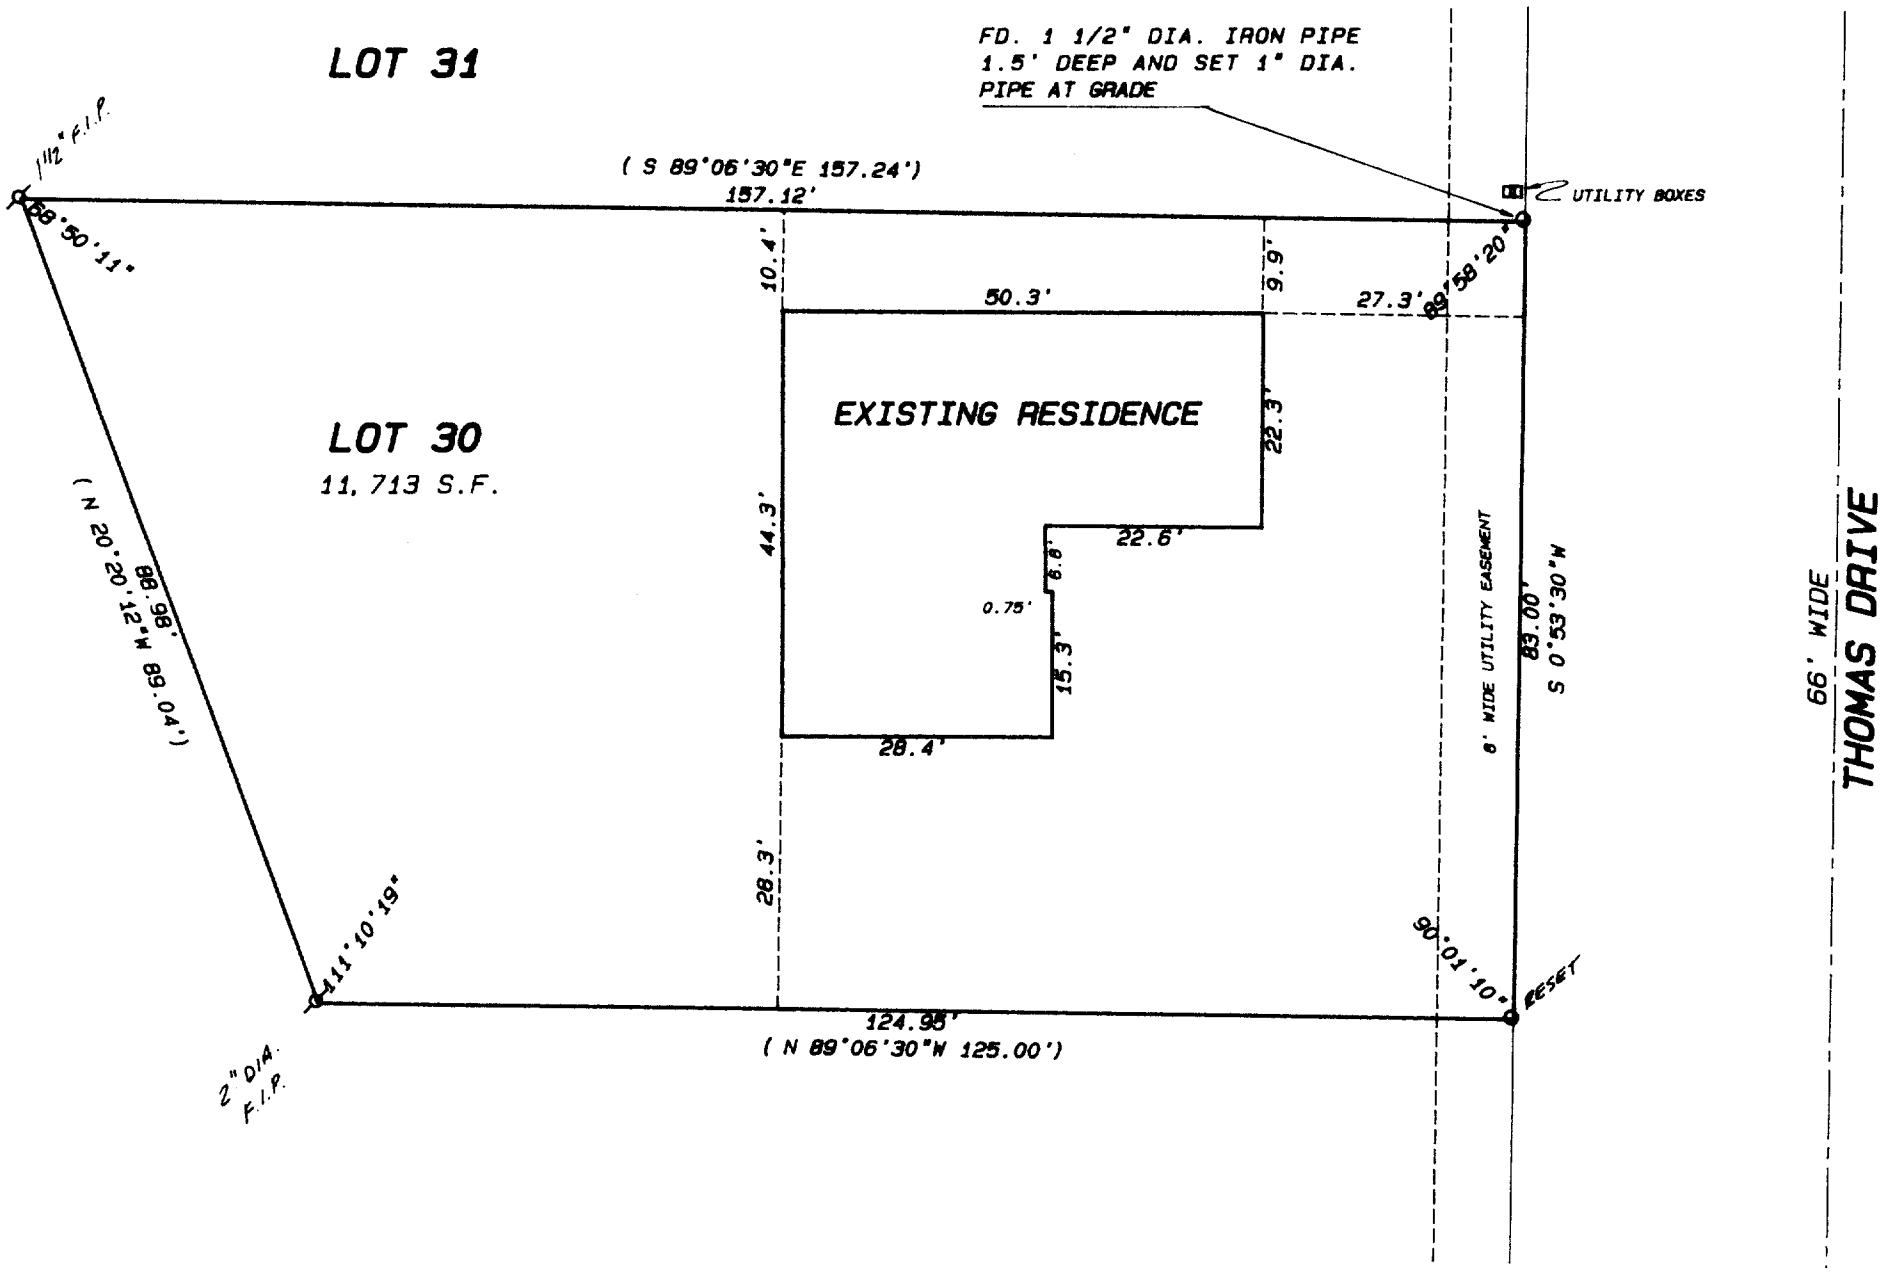

ORDERED BY: NEUMANN HOMES, INC.  
4450 MILTON AVE.  
SUITE 206  
JANESVILLE, WI. 53546

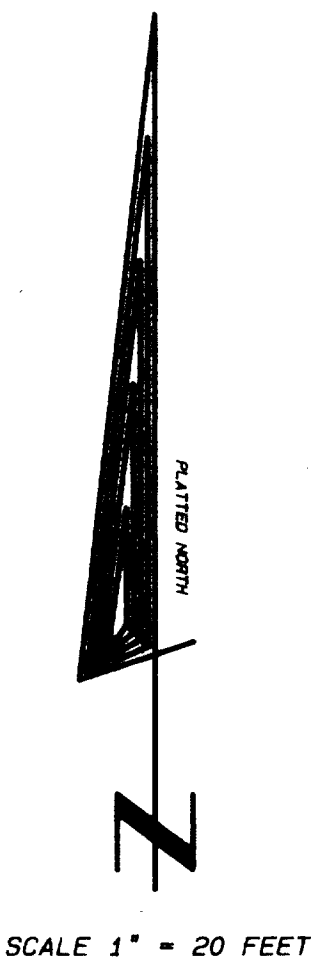

- Legend**
- FOUND IRON PIPE
  - FOUND IRON ROD
  - FOUND BRASS CAPPED MONUMENT
  - FOUND CONCRETE MONUMENT
  - CHISEL CUT IN CONCRETE
  - SET IRON ROD, 24" LONG, WEIGHING 1.5 LBS./LINEAL FT., 3/4" DIA.
  - SET IRON ROD, 30" LONG, WEIGHING 4.5 LBS./LINEAL FT., 1-11/16" DIA.
  - RECORDED AS DIMENSION
  - EXISTING FENCE

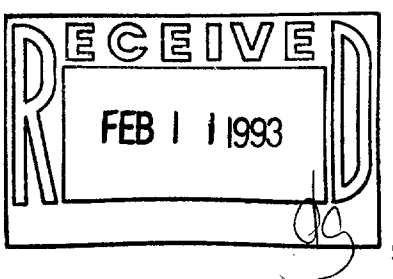

SCALE: 1"= 20 FEET



"I hereby certify that I have surveyed the above described property and that the above map is a true representation thereof and shows the size and location of the property, its exterior boundaries, the location of all visible structures and dimensions of all principal buildings thereon, boundary fences, apparent easements, roadways and visible encroachments, if any."

"This survey is made for the use of the present owners of the property, and also those who purchase, mortgage, or guarantee the title thereto within one year from date hereof."

*Kenneth B. Abernathy, Jr.*

KENNETH B. ABERNATHY, JR.  
WISCONSIN REGISTERED LAND SURVEYOR,  
S-1594

Date: 12/18/92 Job No. 92.1209